

MISSISSIPPI

BOARD OF WATER COMMISSIONERS

416 North State Street

Jackson, Mississippi 39201

CODED

WATER WELL DRILLERS LOG

WAYNE

F 84

6/74

June date well completed

1974 Roy West Water Wells Wayne firm name county well located

LANDOWNER: James Meeks

Rt 6

Laurel

(mailing address)

WELL LOCATION:

sec. 17 T. 9 N. R. 9 E

10 miles E of Sanders MS (distance) (direction) (nearest town)

WELL PURPOSE: home (home, irrigation, municipal, industrial)

WELL COMPLETION DATA:

- (1) diameter (inches) 4
- (2) total depth (feet) 103
- (3) static water level (feet) 70 below top of ground.
- (4) casing PVC, 93 (material) (depth)

(size) if telescope see back.

- (5) screen 10, 93 (length) (depth to top)
- 2, St Steel (size) (material)

- (6) pump 3/4, 12 (HP) (yield gpm)

Rea (type power)

- (7) electric log NO (yes or no)

(organization running log)

- (8) how well bottom plugged washable


description of formations encountered

from to

| | | |
|------------|----|-----|
| clay | 0 | 3 |
| hardy clay | 3 | 20 |
| clay | 20 | 70 |
| hardy clay | 70 | 95 |
| sand | 95 | 103 |

CODED

DRILLERS REMARKS:

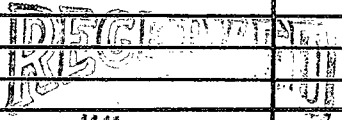

JUL 1974

MISS. BD. OF WATER COMM.

If well telescopes please sketch and show depths.

GROUND LEVEL

| | | | |
|--|---|--|--|
| | | | |
| | X | | |
| | | | |
| | | | |

SECTION 17

Please indicate well location X.

ADDITIONAL INFORMATION

If more than one screen, show locations of each on sketch.