

WAYNE  
F 85  
8-2-74

MISSISSIPPI  
BOARD OF WATER COMMISSIONERS  
416 North State Street  
Jackson, Mississippi 39201

WATER WELL DRILLERS LOG

CODED

Aug 2 1974 Porter Drilling Co Wayne  
date well completed firm name county well located

LANDOWNER: Jimmy  
Bernard

description of formations encountered from to

At 3 Shubuta Ave  
(mailing address)

red clay & sand	0	30
Chalk	30	32
sand	32	39
rock thin		39
blue chalk	39	70
rock strata	70	75
blue chalk	75	114
Wicksburg rock	114	143
white chalk	143	170
blue chalk	170	426
sand & chalk	426	498
blue chalk	498	517
fine sand & lignite	517	521
light fine sand		
& lignite		


WELL LOCATION:  
sec. 2 T 90 N R 9 E  
3 S 5 Circutt  
(distance) (direction) (nearest town)

WELL PURPOSE: none  
(home, irrigation, municipal, industrial)

WELL COMPLETION DATA:

- (1) diameter (inches) 2'
- (2) total depth (feet) 517'
- (3) static water level (feet) 84' (below top of ground)
- (4) casing steel 498' (material) (depth)  
2' (size) if telescope see back.
- (5) screen 11" 506' (length) (depth to top)  
1 1/4" 80 ga bronze pipe (size) (material)
- (6) pump 1 1/2 (HP) 10 (yield gpm)  
elec (type power)
- (7) electric log no (yes or no)
- (organization running log)
- (8) how well bottom plugged  
plugged


11' 30 gal per min  
with 11' 1 1/4" bronze pipe  
Test in with pack  
Set 105' 1 1/4" pipe  
Wicksburg very tight  
3 gal per min  
50' water level

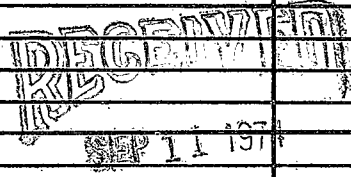

DRILLERS REMARKS: 68' 4"  
cement to cut  
salt water in  
sand

If well telescopes please  
sketch and show depths.

GROUND LEVEL

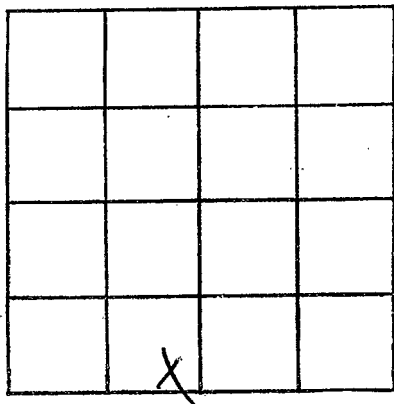

SECTION 2

Please indicate well location X.

ADDITIONAL INFORMATION

If more than one screen,  
show locations of each on sketch.