

WAYNE  
F 86  
8-79

MISSISSIPPI  
BOARD OF WATER COMMISSIONERS  
416 North State Street  
Jackson, Mississippi 39201

CODED

WATER WELL DRILLERS LOG

Aug 74

19 J.P. Green Water Well

Wayne

date well completed

firm name

county well located

LANDOWNER:

Earnest Gilmore  
Rt 1 Box 115 Shubuta, MS  
(mailing address) 39360

description of formations encountered

from

to

White Chalk

0 10

" "

10 20

" "

20 30

" "

30 40

sand

40 50

" "

50 60

" "

60 70

" "

70 75

" "

75

WELL LOCATION:

sec. 24 T 9 N R 9 E  
S W  
15 miles W of Waynesboro  
(distance) (direction) (nearest town)

WELL PURPOSE:

(home, irrigation, municipal, industrial)

WELL COMPLETION DATA:

- (1) diameter (inches) 4"
- (2) total depth (feet) 75'
- (3) static water level (feet) 35 below top of ground.
- (4) casing PVC 70 (material) (depth)
- \_\_\_\_\_ if telescope see back. (size)
- (5) screen 5' 70' (length) (depth to top)
- 2" A.O.D. PVC (size) (material)
- (6) pump 1/2 5 (HP) (yield gpm)
- 110 VAC (type power)
- (7) electric log NO (yes or no)

(organization running log)

- (8) how well bottom plugged \_\_\_\_\_


DRILLERS REMARKS:

DRILLER'S SIGNATURE  
SEP 8 1974  
SEP 8 1974

MISS. BD. OF WATER COMMISSIONERS

If well telescopes please sketch and show depths.

GROUND LEVEL

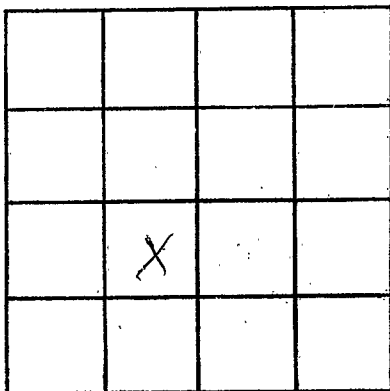

SECTION 24

Please indicate well location X:

ADDITIONAL INFORMATION

If more than one screen,  
show locations of each on sketch.