

WAYNE

F87

12/23/77

MISSISSIPPI BOARD OF WATER COMMISSIONERS 416 North State Street Jackson, Mississippi 39201

CODED

WATER WELL DRILLERS LOG

12/23/77

date well completed

Gwinner Drilling

firm name

Wayne County

county well located

LANDOWNER: Mercedes Hess

East Eucuttalmt 1-10-3

(mailing address)

WELL LOCATION:

sec. 1 T. 9 N R. 9 E

725' S & 150' E of NW corner NWSE

(distance) miles (direction) of (nearest town)

WELL PURPOSE: Well Supply

(home, irrigation, municipal, industrial)

WELL COMPLETION DATA:

- (1) diameter (inches) 3"
(2) total depth (feet) 609'
(3) static water level (feet) 50 below top of ground.
(4) casing Steel 460' (material) (depth)

3" (size) if telescope see back.

- (5) screen NA NA (length) (depth to top)

NA NA (size) (material)

- (6) pump NA 70 (HP) (yield gpm)

A.C. (type power)

- (7) electric log NA (yes or no)

NA (organization running log)

- (8) how well bottom plugged open

ended

DRILLERS REMARKS:

Jummy Hudson

description of formations encountered

from

to

Table with 3 columns: description of formations encountered, from, to. Rows include Sand, Chalk & Ross, Chalk & Ross, Chalk, Chalk streaked, Sand streaked, Sand streaked.


RECEIVED

MAR 10 1978

MISS. Bd. OF WATER COMMISSIONERS

If well telescopes please sketch and show depths.

GROUND LEVEL

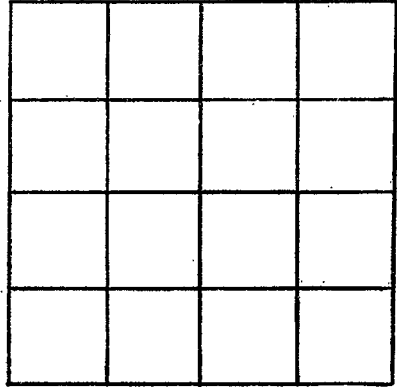

SECTION \_\_\_\_\_

Please indicate well location X.

ADDITIONAL INFORMATION

If more than one screen, show locations of each on sketch.