

WAYNE
F 88
5/31/79

MISSISSIPPI
BOARD OF WATER COMMISSIONERS
416 North State Street
Jackson, Mississippi 39201

CODED

WATER WELL DRILLERS LOG

5-3 79 Griner Drilling Wayne
date well completed firm name county well located

LANDOWNER:
Marion Corporation
P.O. Box 51207
Lafayette, La. 70505
(mailing address)

description of formations encountered	from	to
clay + sand	0	63
sand	63	84
sand, with little clay	84	105
clay	105	126
clay + rocks	126	189
clay	189	211
clay, rock, + sand	211	252
clay	252	315
clay + sand	315	357
clay	357	378
clay + sand	378	420
clay	420	525
clay	525	546
sand	546	604
clay	604	650
clay	650	660

WELL LOCATION: 2000'S + 1660'E
sec. 10 T. 9 N R. 9 E of
Wayne Sandersville
(distance) miles (direction) of (nearest town)

WELL PURPOSE: oil field supply
(home, irrigation, municipal, industrial)

- WELL COMPLETION DATA:
- (1) diameter (inches) 4"
 - (2) total depth (feet) 660'
 - (3) static water level (feet) 110' below top of ground.
 - (4) casing Steel 651' (material) (depth)
4" if telescope see back. (size)
 - (5) screen 42' 609' (length) (depth to top)
4" perforated (size) (material)
 - (6) pump 70 (HP) (yield gpm)
AC (type power)
 - (7) electric log (yes or no)
 - (organization running log)
 - (8) how well bottom plugged, orange peel

Miss. Board of Water Comm.


MAY 29 1979

DRILLERS REMARKS:

RECEIVED

If well telescopes please sketch and show depths.

GROUND LEVEL

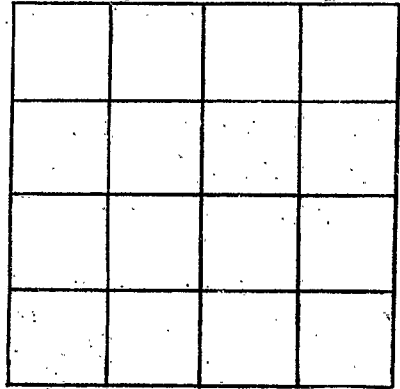

SECTION _____

Please indicate well location X.

ADDITIONAL INFORMATION

If more than one screen, show locations of each on sketch.