

MISSISSIPPI DEPARTMENT OF NATURAL RESOURCES

Bureau of Land and Water Resources

Southport Mall

P.O. Box 10631

Jackson, Mississippi 39209

WATER WELL DRILLERS LOG

CODED

WAYNE
F.92
2-3-85

2-3-85

Griner Drilling Service, INC.

Wayne

date well completed

firm name

county well located

LANDOWNER:	description of formations encountered	from	to
<i>murco Drilling Corp.</i>			
<i>1908 Beek Bldg.</i>	<i>clay, rock, sand</i>	<i>50</i>	<i>672</i>
<i>Shreveport, La. 71101</i>			
(mailing address)			

WELL LOCATION: *833'N + 520'E*

sec. *14* T. *9* N. R. *9* E SW/400'

No. *1* Dr. *W. Excute Field* (distance) miles (direction) of (nearest town)

WELL PURPOSE: *oil field supply*
(home, irrigation, municipal, industrial)

WELL COMPLETION DATA:

- (1) diameter (inches) *3"*
- (2) total depth (feet) *672'*
- (3) static water level (feet) *100'* ^{below} / _{above} top of ground.
- (4) casing *steel 546'*
(material) (depth)
- 3"*
(size) if telescope see back.
- (5) screen *Open ended*
(length) (depth to top)
- (size) (material)
- (6) pump *70*
(HP) (yield gpm)
- AC*
(type power)
- (7) electric log *(yes or no)*
- (organization running log)

(8) how well bottom plugged *orange peel*


DRILLERS REMARKS:

RECEIVED
FEB 25 1995

Department of Natural Resources
Bureau of Land & Water Resources

If well telescopes please sketch and show depths.

GROUND LEVEL

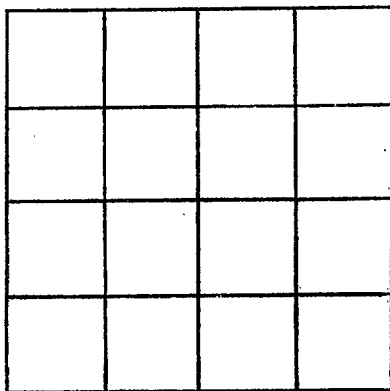

SECTION _____

Please indicate well location X.

ADDITIONAL INFORMATION

If more than one screen,
show locations of each on sketch.