

MISSISSIPPI DEPARTMENT OF NATURAL RESOURCES

Bureau of Land and Water Resources

Southport Mall

P.O. Box 10631

Jackson, Mississippi 39209

WATER WELL DRILLERS LOG

CODED

WAYNE  
F 96  
8/15/85

Aug 15

1985 Park Drilling Co., Inc.

Itasca

date well completed

firm name

county well located

LANDOWNER: Copeland Daves

description of formations encountered

from

to

211 Shubert, Ms.

(mailing address)

WELL LOCATION:

sec. 2 T 90 N 9 E  
S W  
2 miles S of Encantado  
(distance) (direction) (nearest town)

WELL PURPOSE: Machine Ground  
(home, irrigation, municipal, industrial)

WELL COMPLETION DATA:

- (1) diameter (inches) 4" x 2"
- (2) total depth (feet) 560'
- (3) static water level (feet) 95' below top of ground.
- (4) casing steel 315' - 540' 2" (material) (depth)
- 4" x 2" If telescope see back. (size)
- (5) screen 20' 540' (length) (depth to top)
- 2" 6 slot S.S. (size) (material)
- (6) pump 1 HP 1.8 (HP) (yield gpm)
- elec. (type power)
- (7) electric log no (yes or no)

clay + sand	0	23
clay	23	54
clay	54	57
clay	57	66
rock stratum	66	76
clay	76	112
Victorville rock stratum	112	132
white clay some sand	132	170
blue clay	170	195
sand + clay + coarse	195	210
clay	210	414
soft rock stratum	414	430
clay	430	475
sand with clay	475	510
sand - some clay	510	522
clay	522	525
lime sand some clay	525	545
machine firm sand	545	555
new fire firm sand		
with some clay	555	562
clay some sand	562	570
with some clay		

CODED


RECEIVED  
AUG 27 1985

DRILLERS REMARKS:

Department of Natural Resources  
Bureau of Land & Water Resources

If well telescopes please sketch and show depths.

GROUND LEVEL

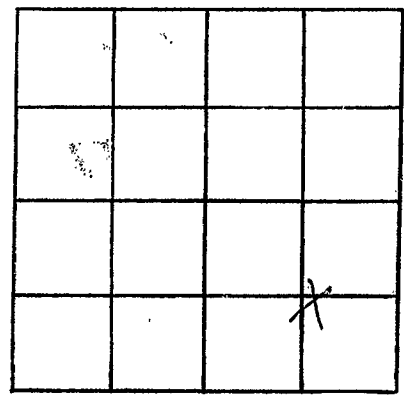

SECTION 2

Please indicate well location X.

ADDITIONAL INFORMATION

Lined area for additional information.

If more than one screen, show locations of each on sketch.