

DEC

MISSISSIPPI DEPARTMENT OF ENVIRONMENTAL QUALITY

Office of Land and Water Resources

P. O. Box 10631  
Jackson, MS 39289-0631

WATER WELL DRILLERS LOG

COUNTY WELL LOCATED  
**WAYNE**

WELL NUMBER **F 99** CODED

DATE WELL COMPLETED  
**11-27-96**

PERMIT NUMBER

NAME OF DRILLING FIRM  
**A-1 DRILLING SERV**

**LAUREL, MS**

NAME & MAILING ADDRESS OF LANDOWNER  
**WHISTLER WATER ASSN**

**7 BEAT 4 - SHUBOTA RD**

**WAYNESBORO, MS 39367**

WELL LOCATION: SEC **33** TOWNSHIP **9 N** RANGE **9 W**

DISTANCE **13** Miles **E** DIRECTION of **LAUREL** NEAREST TOWN

OTHER LANDMARK

WELL PURPOSE: Home, Irrigation, Municipal, Industrial, Fish Pond, etc.  
**TEST HOLE ONLY**

PUMP DATA

PUMP TYPE (Circle One): Submersible, Turbine, Jet, Flowing Well, Other (Describe) **NONE**

POWER TYPE (Circle One): Electric, Tractor, Diesel, Gasoline, Butane, Other (Describe) **NONE**

Pump Capacity (GPM) No. of Stages Setting Depth **FT.**

PUMP TEST

Well yielded **DEC 18 1996** GPM with a drawdown of **NONE** ft. after **NONE** hours of pumping

WELL DATA

Well Depth **290** Casing Diameter (In.) **NA** Casing Length (Ft.) **NA**

Type of Casing **NA** Hole Depth **NA** Depth to Static Water Level **NA**

TYPE OF COMPLETION: (Circle One or More): Gravel Packed, Underreamed, Telescoped, Natural Development, Open Hole, Other (Describe)

WELL GROUTED TO A DEPTH OF **X** FEET  
Type Grout (circle one): Cement, Bentonite, or Mix

LOG DATA

TYPE OF LOG RUN (Circle One): No Log Run, Electric, Gamma Ray, Density, Sonic, Neutron, Other (Describe)

Name of Organization Running Log  
**BUREAU OF GEOLOGY**

GEOLOGIC DATA (Office Use Only)

Surface Elev.	Geologic Unit	Unit Thickness	Depth to Top
<b>310</b>			
Subs. SWL	Date	Analysis	Aquifer Test

SCREEN DATA

Diameter - Inches Length - Feet Slot Size - Inches

Screen Type Depth to Bottom - Feet

Driller's Remarks  
**Plugged & abandoned**

Top of Lap Pipe or Reduction in Casing


FEET IF TELESCOPED OR MORE THAN ONE SCREEN: USE BACK PAGE

DESCRIPTION OF FORMATIONS ENCOUNTERED	FROM	TO	FORMATIONS (Continued)	FROM	TO
Top soil	0	1	Sand, white	70	74
Clay, red, sandy	1	7	Clay	74	76
Sandstone	7	7 1/2	Sand, white	76	82
Clay, white-tan	7 1/2	16	Clay, lt. gray	82	85
Clay, lt. gray	16	26	Sand	85	86
Rock	26	26 1/2	Clay, lt. gray	86	87 1/2
Clay, lt. gray	26 1/2	43	Sand, white w/ orange	89	145
Rock ledges	43	45	Hard streak	145	
Clay, gray	45	48	Clay, green	145	178
Rock, hard	48	48 1/2	Sand	178	180
Clay, lt. gray	48 1/2	70			

IF MORE SPACE IS NEEDED, USE BACK

If well telescopes please sketch and show depths.

GROUND LEVEL

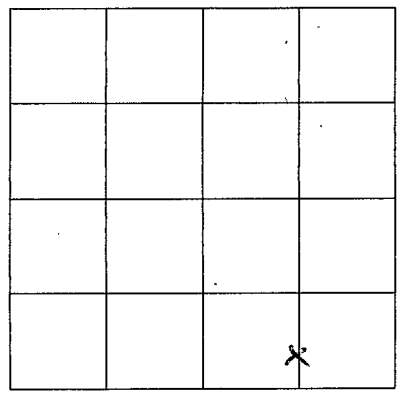

SECTION 33

Please indicate well location X.

ADDITIONAL INFORMATION

- 180-200 Clay, sandy w/sand streaks
- 200-203 Sand, gray
- 203-204 Clay
- 204-214 Sand, gray
- 214-217 Clay
- 217-217 1/2 Rock
- 217 1/2-230 Sand, gray
- 230-237 1/2 Rock
- 237 1/2-239 Clay
- 239-239 1/2 Rock
- 239 1/2-240 Clay
- 240-240 1/2 Rock
- 240 1/2-242 Clay
- 242-243 Rock
- 243-250 Clay, stiff, gray
- 250-250 1/2 Rock
- 250 1/2-253 Clay
- 253-256 Sandy w/ sea shells
- 256-290 Clay, dark gray, stiff

If more than one screen, show location of each on sketch.