

Wayne  
F 2000

*need date*

MISSISSIPPI  
BOARD OF WATER COMMISSIONERS  
416 North State Street  
Jackson, Mississippi 39201

13¢

WATER WELL DRILLERS LOG

date well completed 19 JR Green Water Well Dring firm name WAYNE county well located

LANDOWNER: LIZZIE ARRINGTON

Route #1  
Shubuta MS  
(mailing address)

WELL LOCATION:  
sec 22 T 9 N R 9 E  
5 miles NW of Whistler  
(distance) (direction) (nearest town)

WELL PURPOSE:  
(home, irrigation, municipal, industrial)

WELL COMPLETION DATA:

- (1) diameter (inches) 4
- (2) total depth (feet) 120
- (3) static water level (feet) 32 below above top of ground.
- (4) casing PVC, 110,  
(material) (depth)  
(size) If telescope see back.
- (5) screen 10", 110  
(length) (depth to top)
- 2 x .008, PVC  
(size) (material)
- (6) pump 1, 6  
(HP) (yield gpm)  
220V AC  
(type power)
- (7) electric log NO  
(yes or no)
- (organization running log)
- (8) how well bottom plugged


description of formations encountered	from	to
<u>Yellow Clay</u>	<u>0</u>	<u>10</u>
<u>" "</u>	<u>10</u>	<u>20</u>
<u>" "</u>	<u>20</u>	<u>30</u>
<u>" "</u>	<u>30</u>	<u>38</u>
<u>SAND</u>	<u>38</u>	<u>40</u>
<u>" "</u>	<u>40</u>	<u>46</u>
<u>white Chalk</u>	<u>46</u>	<u>50</u>
<u>" "</u>	<u>50</u>	<u>52</u>
<u>SAND</u>	<u>52</u>	<u>54</u>
<u>white Chalk</u>	<u>54</u>	<u>60</u>
<u>" "</u>	<u>60</u>	<u>70</u>
<u>" "</u>	<u>70</u>	<u>80</u>
<u>" "</u>	<u>80</u>	<u>90</u>
<u>FINE SAND MUD</u>	<u>90</u>	<u>95</u>
<u>white Chalk</u>	<u>95</u>	<u>100</u>
<u>SAND</u>	<u>100</u>	<u>110</u>
<u>" "</u>	<u>110</u>	<u>120</u>

DRILLERS REMARKS:  
LAST Circulation at 120'

JUN - 1 1976

If well telescopes please sketch and show depths.

GROUND LEVEL

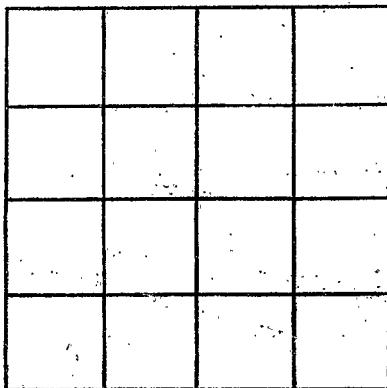

NE NW

SECTION 22

Please indicate well location X.

ADDITIONAL INFORMATION

If more than one screen, show locations of each on sketch.