

need date

Wayne
F 2001

MISSISSIPPI
BOARD OF WATER COMMISSIONERS
416 North State Street
Jackson, Mississippi 39201

WATER WELL DRILLERS LOG

date well completed 19 J.R. Green Water Well Drilling firm name WAYNE county well located

LANDOWNER: JAMES BRINGTON
Route #11
Shubuta Ms
(mailing address)

WELL LOCATION:
sec. 22 T. 9 (N) R. 9 E
5 miles NW of Whistler
(distance) (direction) (nearest town)

WELL PURPOSE:
(home, irrigation, municipal, industrial)

- WELL COMPLETION DATA:
- (1) diameter (inches) 4
 - (2) total depth (feet) 120
 - (3) static water level (feet) 32 below above top of ground.
 - (4) casing PVC, 85
(material) (depth)
5 if telescope see back.
(size)
 - (5) screen 5 85
(length) (depth to top)
2x.008, PVC
(size) (material)
 - (6) pump 3/4 5
(HP) (yield gpm)
110V AC
(type power)
 - (7) electric log NO
(yes or no)
 - (organization running log)
 - (8) how well bottom plugged

description of formations encountered	from	to
yellow clay	0	10
" "	10	20
" "	20	24
SAND	24	30
" "	30	40
" "	30	45
white CHALK	45	50
" "	50	60
" "	60	70
" "	70	80
SAND	80	90
CHALK	90	100
" "	100	110
SAND	110	120


REGISTERED
MAY 1 1976

MISS. BD. OF WATER COMMISSIONERS

DRILLERS REMARKS:

If well telescopes please sketch and show depths.

GROUND LEVEL

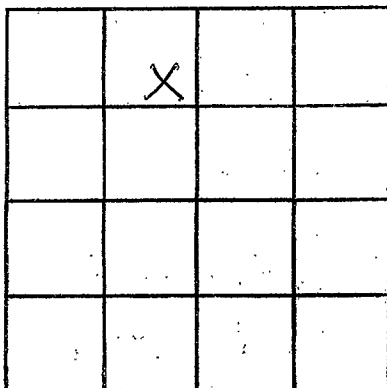

NE NW

SECTION 22

Please indicate well location X.

ADDITIONAL INFORMATION

If more than one screen, show locations of each on sketch.