

Need date

Wayne  
 F 2002

MISSISSIPPI  
 BOARD OF WATER COMMISSIONERS  
 416 North State Street  
 Jackson, Mississippi 39201

WATER WELL DRILLERS LOG

19 J.R. Green/Inter Well Dring Wayne  
 date well completed firm name county well located

LANDOWNER: Daniel Povey

Route 6

LAUREL, MS. 39440  
 (mailing address)

WELL LOCATION:

sec. 32 T-9 N R-9 E  
12 miles E of LAUREL  
 (distance) (direction) (nearest town)

WELL PURPOSE:

(home, irrigation, municipal, industrial)

WELL COMPLETION DATA:

- (1) diameter (inches) 4
- (2) total depth (feet) 45
- (3) static water level (feet) 32 below above top of ground.
- (4) casing PVC 40  
 (material) (depth)  
 (size) if telescope see back.
- (5) screen 10' 35  
 (length) (depth to top)  
2x.008 PVC  
 (size) (material)
- (6) pump 1 5  
 (HP) (yield gpm)  
 (type power)
- (7) electric log NO  
 (yes or no)  
 (organization running log)
- (8) how well bottom plugged

description of formations encountered

from to


SAND	0	10
"	10	20
"	20	30
"	30	40
"	40	45
white CHALK	45	

DRILLERS REMARKS:

JUN 1 1970  
 MISS. Bd. OF WATER COMMISSIONERS

If well telescopes please sketch and show depths.

GROUND LEVEL

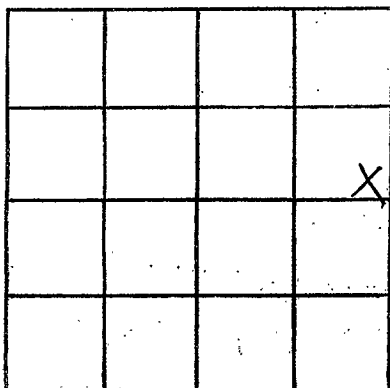

SE 1/4 NE 1/4

SECTION 32

Please indicate well location X.

ADDITIONAL INFORMATION

If more than one screen, show locations of each on sketch.