

WAYNE

F 2007

2-4-78

MISSISSIPPI BOARD OF WATER COMMISSIONERS 416 North State Street Jackson, Mississippi 39201

WATER WELL DRILLERS LOG

2 4 78 date well completed

AR Bernard Water Well firm name

Wayne county well located

LANDOWNER: Demit Craft R. Shubuta miss. (mailing address)


WELL LOCATION: sec. 14 T. 9. N R. 9. E 5 N-W WHISTLER (distance) miles (direction) of (nearest town)

WELL PURPOSE: (home, irrigation, municipal, industrial)

- WELL COMPLETION DATA: (1) diameter (inches) 4 (2) total depth (feet) 100 (3) static water level (feet) 52 below top of ground. (4) casing PVC 90 (material) (depth) (size) If telescope see back. (5) screen 5' 90 (length) (depth to top) 2" x 100' PVC (size) (material) (6) pump 1 6 (HP) (yield gpm) AC (type power) (7) electric log NO (yes or no) (organization running log) (8) how well bottom plugged

Table with 4 columns: description of formations encountered, from, to. Rows include Red Clay, Blue, fine sand, Yellow Clay, white Chalk, Hard Rock, Blue Chalk, fine sand, White Chalk, med sand.


DRILLERS REMARKS:

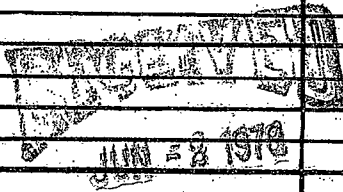

MISS. Bd. OF WATER COMMISSIONERS

If well telescopes please sketch and show depths.

GROUND LEVEL

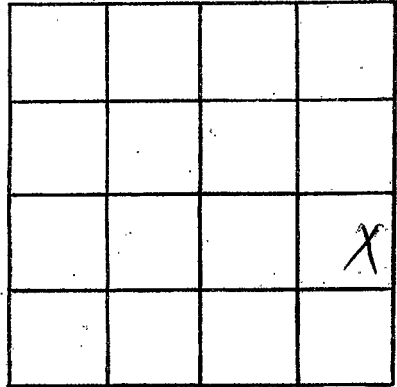

SECTION

14

Please indicate well location X.

ADDITIONAL INFORMATION

If more than one screen,
show locations of each on sketch.