

WAYNE

F 2008

3-30-78

MISSISSIPPI BOARD OF WATER COMMISSIONERS 416 North State Street Jackson, Mississippi 39201

WATER WELL DRILLERS LOG

Mar 30 1978 Reg. W. & S. Washburne Wayne date well completed firm name county well located

LANDOWNER: Nick Reynolds RT 1 Box 179B Shubuta Miss (mailing address)


Table with 3 columns: Description of formations encountered, from, to. Entries: clay (0-6), sand & clay (6-40), sand (40-86)

WELL LOCATION: sec. 1 T 9 N S R 9 E W 10 miles W of Waynesboro (distance) (direction) (nearest town)

WELL PURPOSE: Home (home, irrigation, municipal, industrial)

- WELL COMPLETION DATA: (1) diameter (inches) 2 in (2) total depth (feet) 86 (3) static water level (feet) 40 below top of ground. (4) casing PVC 81 (material) (depth) (size) If telescope see back. (5) screen 5 ft 81 (length) (depth to top) 1/2 steel (size) (material) (6) pump 3/4 7 (HP) (yield gpm) Rea (type power) (7) electric log No (yes or no) (organization running log) (8) how well bottom plugged Washburne


DRILLERS REMARKS:

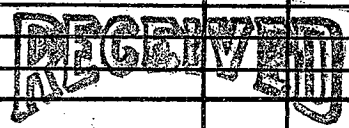

MAY 5 - 1978

If well telescopes please sketch and show depths.

GROUND LEVEL

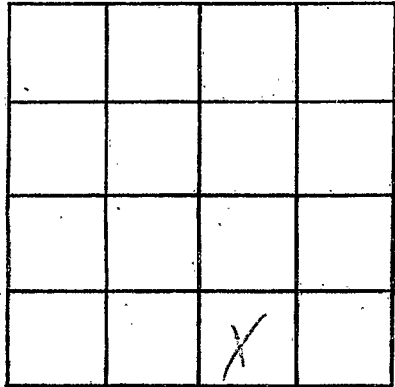

SECTION 1

Please indicate well location X.

ADDITIONAL INFORMATION

If more than one screen, show locations of each on sketch.