

WAYNE

F 2010

11-14-78

MISSISSIPPI BOARD OF WATER COMMISSIONERS 416 North State Street Jackson, Mississippi 39201

WATER WELL DRILLERS LOG

11-14-78 date well completed

J.R. Green Water Well Drilling firm name

WAYNE county well located

LANDOWNER: GRADY Langley

Route One Shobuts, MS (mailing address)

description of formations encountered

from to

Table with 3 columns: description of formations encountered, from, to. Rows include Red Sand (0-10), White (10-20), Blue (50-52), Clay (52-60), Shell (60-70), Rack (75-76), Blue Clay (76-80), and others.

WELL LOCATION:

sec. 4 T. 9 N R. 9 E 3 miles S of Euclypta (distance) (direction) (nearest town)

WELL PURPOSE:

(home, irrigation, municipal, industrial)

WELL COMPLETION DATA:

- (1) diameter (inches) 14"
(2) total depth (feet) 97'
(3) static water level (feet) 46 below top of ground.
(4) casing PVC 60 (material) (depth)
(5) screen 5" 60 (length) (depth to top)
(6) pump 1 5 (HP) (yield gpm)
(7) electric log NO (yes or no)

(organization running log)

(8) how well bottom plugged

DRILLERS REMARKS:


RECEIVED stamp

DEC 28 1978 stamp

MISS. BD. OF WATER COMMISSIONERS

If well telescopes please sketch and show depths.

GROUND LEVEL

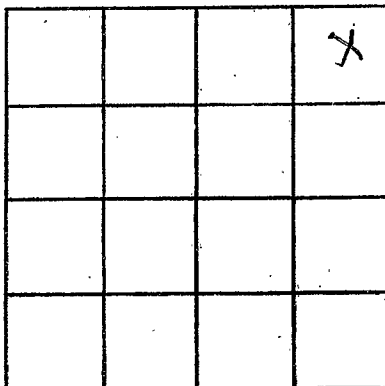

SECTION 11

Please indicate well location X.

ADDITIONAL INFORMATION

If more than one screen,
show locations of each on sketch.