

Wayne
Ford

MISSISSIPPI
BOARD OF WATER COMMISSIONERS
416 North State Street
Jackson, Mississippi 39201

8-30-79

WATER WELL DRILLERS LOG

8-20 1979 Rog West Waterworks Corp
date well completed firm name county well located

LANDOWNER: Riley Block
Rt 4
Waynesboro
(mailing address)

Description of formations encountered	from	to
clay	0	8
sandy clay	8	25
sand	25	70
blue clay	70	110
limestone str	110	230

WELL LOCATION:
sec. 2 T 9 N R 9 E
S W
4 miles S of Evadale
(distance) (direction) (nearest town)

WELL PURPOSE: home
(home, irrigation, municipal, industrial)

WELL COMPLETION DATA:

(1) diameter (inches) 2

(2) total depth (feet) 230

(3) static water level (feet) 60 below above top of ground.

(4) casing galv, 126,
(material) (depth)
(size) if telescope see back.

(5) screen 0 0
(length) (depth to top)
0 0
(size) (material)

(6) pump 1 8
(HP) (yield gpm)
R&A
(type power)

(7) electric log NO
(yes or no)

(organization running log)

(8) how well bottom plugged open end

DEPT. OF NATURAL RESOURCES
BUREAU OF LAND & WATER RESOURCES


OCT 9 1979

DRILLERS REMARKS:

RECEIVED

If well telescopes please sketch and show depths.

GROUND LEVEL

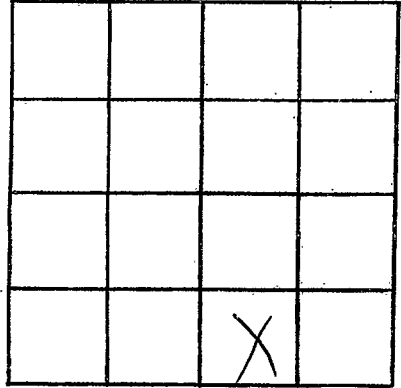

SECTION 2

Please indicate well location X.

ADDITIONAL INFORMATION

If more than one screen,
show locations of each on sketch.