

to be mailed

Wayne
Foods
5-25-79

MISSISSIPPI
BOARD OF WATER COMMISSIONERS
416 North State Street
Jackson, Mississippi 39201

WATER WELL DRILLERS LOG

5-25-79 J. R. GREEN - WATER WELL DRILLING
date well completed 19 79 RTE. 6, BOX 127 PHONE Wayne
LAUREL, MISS. 39440 county well located

LANDOWNER: Houston Blackledge
Routes Heidelberg MS
(mailing address)

WELL LOCATION:
sec. 13 T. 9 N. R. 9 E
24 W. EUGETTA
miles 4 of (nearest town)

WELL PURPOSE:
(home, irrigation, municipal, industrial)

WELL COMPLETION DATA:

- (1) diameter (inches) 4
- (2) total depth (feet) 180
- (3) static water level (feet) _____ below above top of ground.
- (4) casing (material) 1 1/2 (depth) _____
(size) if telescope see back.
- (5) screen 5 1 1/2
(length) (depth to top)
(size) (material)
- (6) pump _____ (HP) _____ (yield gpm)
(type power)
- (7) electric log No
(yes or no)
(organization running log)
- (8) how well bottom plugged _____

description of formations encountered	from	to
Red Clay	0	10
Red Sand	10	20
Blue clay	20	30
" "	30	40
" "	40	45
Rock	45	47
Blue clay	47	50
Shell & Sand	50	60
Blue clay	60	70
" "	70	80
" "	80	82
Rock	82	90
" "	90	100
Shell	100	105
" "	105	110
" "	110	130
white clay	130	140
" "	140	150
" "	150	160
" "	160	170
fine sand	170	180


DEPT. OF NATURAL RESOURCES
BUREAU OF LAND & WATER

JAN 1980
RECEIVED

DRILLERS REMARKS:
well did not give water

If well telescopes please sketch and show depths.

GROUND LEVEL

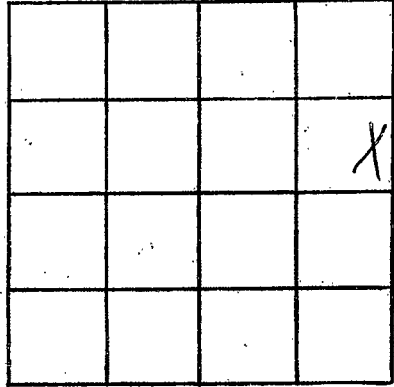

SECTION 13

Please indicate well location X.

ADDITIONAL INFORMATION

If more than one screen, show locations of each on sketch.