

MISSISSIPPI
BOARD OF WATER COMMISSIONERS
416 North State Street
Jackson, Mississippi 39201

WATER WELL DRILLERS LOG

Wayne
F. Jones
2-15-80

2-15 1980 ROY WEST DRILLING Wayne
date well completed firm name county well located

LANDOWNER: THADDIS PRYOR

description of formations encountered	from	to
	<u>SAND</u>	<u>0'</u>
<u>CLAY</u>	<u>12'</u>	<u>52'</u>
<u>SAND</u>	<u>52'</u>	<u>70'</u>

(mailing address)

WELL LOCATION:
sec. 29 T 9 N R 9 E
S W
11 miles E of LAUREL
(distance) (direction) (nearest town)

WELL PURPOSE: Home
(home, irrigation, municipal, industrial)

WELL COMPLETION DATA:

- (1) diameter (inches) 2
- (2) total depth (feet) 70'
- (3) static water level (feet) 20' below top of ground.
- (4) casing PVC 64'
(material) (depth)
If telescope see back.
(size)
- (5) screen 6' 64'
(length) (depth to top)
1/4 STAINLESS STEEL
(size) (material)
- (6) pump 1 10
(HP) (yield gpm)
REA
(type power)
- (7) electric log NO
(yes or no)
(organization running log)
- (8) how well bottom plugged WASH UP

DEPT. OF NATURAL RESOURCES
BUREAU OF LAND & WATER RESOURCES


MAY 14 1980

RECEIVED

DRILLERS REMARKS:

If well telescopes please sketch and show depths.

GROUND LEVEL

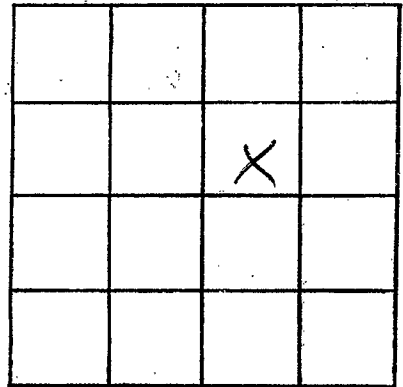

SECTION _____

Please indicate well location X.

ADDITIONAL INFORMATION

If more than one screen,
show locations of each on sketch.