

BOARD OF WATER COMMISSIONERS

416 North State Street

Jackson, Mississippi 39201

WATER WELL DRILLERS LOG

4-1-80
April 1 1980
date well completed

C.P. Clark Water Well Drilling
firm name

county well located

LANDOWNER: Ms. Viola Gray

Route 1, Box 378

Laurel, Miss
(mailing address)

description of formations encountered

from to

Sandy clay 0 5
Red clay 5 12
Sand w/ white clay 12 50
Fine to coarse sand 50 66

WELL LOCATION:

sec. 33 T 9 N R 9

15 miles W of Wimper
(distance) (direction) (nearest town)

WELL PURPOSE:

Home
(home, irrigation, municipal, industrial)

WELL COMPLETION DATA:

(1) diameter (inches) 2
(2) total depth (feet) 66
(3) static water level (feet) 40 below top of ground.

(4) casing galv. st. 61'
(material) (depth)
2 If telescope see back.
(size)

(5) screen 5' 61'
(length) (depth to top)
1 1/4" stainless steel
(size) (material)

(6) pump 1 10
(HP) (yield gpm)
220 V
(type power)

(7) electric log no
(yes or no)
(organization running log)

(8) how well bottom plugged BWW

DRILLERS REMARKS:


DEPT. OF NATURAL RESOURCES
BUREAU OF LAND & WATER RESOURCES

APR 10 1980

RECEIVED

If well telescopes please sketch and show depths.

GROUND LEVEL

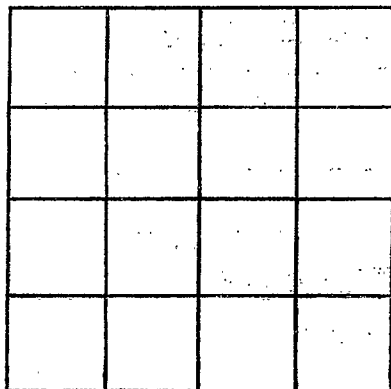

SECTION _____

Please indicate well location X.

ADDITIONAL INFORMATION

If more than one screen, show locations of each on sketch.