

Wayne

5

MISSISSIPPI BOARD OF WATER COMMISSIONERS  
416 North State Street  
Jackson, Mississippi 39201

F 2018  
10-2-80

WATER WELL DRILLERS LOG

6-2 1980 *John Green Water Well Drill* Wayne  
date well completed firm name county well located

| LANDOWNER              | description of formations encountered | from      | to        |
|------------------------|---------------------------------------|-----------|-----------|
| <i>Nickie Fleming</i>  | <i>white clay</i>                     | <i>0</i>  | <i>10</i> |
| <i>Route 1 Shobuta</i> | <i>" "</i>                            | <i>10</i> | <i>20</i> |
|                        | <i>white sand</i>                     | <i>20</i> | <i>30</i> |
|                        | <i>" "</i>                            | <i>30</i> | <i>35</i> |
|                        | <i>Blue clay</i>                      |           |           |

(mailing address)

WELL LOCATION:



(distance) miles (direction) of (nearest town)

WELL PURPOSE:

(home, irrigation, municipal, industrial)

WELL COMPLETION DATA:

- (1) diameter (inches) 4
- (2) total depth (feet) 35
- (3) static water level (feet) 26 below above top of ground.
- (4) casing PVC 30'  
(material) (depth)
- (size) if telescope see back.
- (5) screen 5' 30  
(length) (depth to top)
- 2x108 PVC  
(size) (material)
- (6) pump 1   
(HP) (yield gpm)
- (type power)
- (7) electric log   
(yes or no)
- (organization running log)
- (8) how well bottom plugged

DEPT. OF NATURAL RESOURCES  
BUREAU OF LAND & WATER RESOURCES

JUN 30 1980


RECEIVED

DRILLERS REMARKS:

*Did not produce  
Required amount of  
water*

If well telescopes please sketch and show depths.

GROUND LEVEL

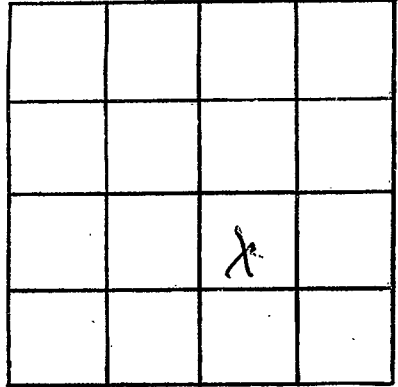

SECTION 14

Please indicate well location X.

ADDITIONAL INFORMATION

If more than one screen,  
show locations of each on sketch.