

WAYNE
 F-2000
 7/14/80

MISSISSIPPI
 BOARD OF WATER COMMISSIONERS
 416 North State Street
 Jackson, Mississippi 39201

WATER WELL DRILLERS LOG

July 14 1980 Roy V. West Drig Wayne
 date well completed firm name county well located

LANDOWNER:	description of formations encountered	from	to
(mailing address)			
Johnny Flemming	CLAY	0	10
Rt 1 Shubuta	SAND	10	35
	CLAY	35	39
	SAND	39	60
<p>WELL LOCATION:</p> <p>sec. 13 T 9 N R 9 E 5 S W</p> <p>_____ miles _____ of _____ (distance) (direction) (nearest town)</p> <p>WELL PURPOSE: (home, irrigation, municipal, industrial)</p> <p>WELL COMPLETION DATA:</p> <p>(1) diameter (inches) 2"</p> <p>(2) total depth (feet) 60'</p> <p>(3) static water level (feet) 20' below above top of ground.</p> <p>(4) casing PVC SS' (material) (depth) _____ (size) If telescope see back.</p> <p>(5) screen 5' 55' (length) (depth to top) 1 1/4" STAINLESS STEEL (size) (material)</p> <p>(6) pump 1 4 (HP) (yield gpm)</p> <p>REA (type power)</p> <p>(7) electric log NO (yes or no) _____ (organization running log)</p> <p>(8) how well bottom plugged WASH VALVE</p> <p>DRILLERS REMARKS:</p>			


DEPT. OF NATURAL RESOURCES
 BUREAU OF LAND & WATER RESOURCES

AUG 3 1980

RECEIVED

If well telescopes please sketch and show depths.

GROUND LEVEL

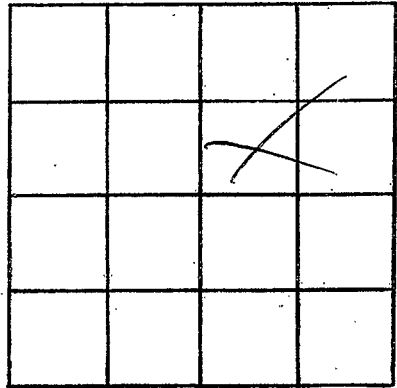

SECTION _____

Please indicate well location X.

ADDITIONAL INFORMATION

If more than one screen,
show locations of each on sketch.