

MISSISSIPPI DEPARTMENT OF NATURAL RESOURCES

Bureau of Land and Water Resources

Southport Mall

P.O. Box 10631

Jackson, Mississippi 39209

WATER WELL DRILLERS LOG

WAYNE
F 2021
4-16-81

April 16 1981 Booth Drilling Wayne  
 date well completed firm name county well located

LANDOWNER: Marvin Davis  
Attn: Shubuta Miss

description of formations encountered	from	to
red clay	0	10
brown sandy clay	10	33
thin rock		33
blue clay	33	50
rock	50	53
clay	53	65
rock strata	65	70
clay	70	113
hard, thickening	113	132
white clay	132	150

(mailing address)

WELL LOCATION:  
 sec. 2 T. 9 N. R. 9 E.  
2 miles S of Escatha  
 (distance) (direction) (nearest town)

WELL PURPOSE: log porch  
 (home, irrigation, municipal, industrial)

WELL COMPLETION DATA:

(1) diameter (inches) 2"  
 (2) total depth (feet) 150  
 (3) static water level (feet) 48 below above top of ground.  
 (4) casing steel 113'  
 (material) (depth)  
2' if telescope see back.  
 (size)  
 (5) screen none use  
 (length) (depth to top)  
 (size) (material)  
 (6) pump 1 4  
 (HP) (yield gpm)  
alex  
 (type power)  
 (7) electric log no  
 (yes or no)  
 (organization running log)

84' 1 1/4" galv drive pipe

(8) how well bottom plugged open

DRILLERS REMARKS:


DEPT. OF NATURAL RESOURCES  
 BUREAU OF LAND & WATER RESOURCES

MAY - 7 1981

RECEIVED

If well telescopes please sketch and show depths.

GROUND LEVEL

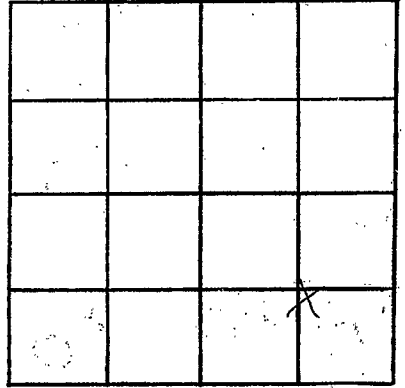

SECTION 2

Please indicate well location X.

ADDITIONAL INFORMATION

If more than one screen,  
show locations of each on sketch.