

Wayne  
F 2053

MISSISSIPPI  
 BOARD OF WATER COMMISSIONERS  
 416 North State Street  
 Jackson, Mississippi 39201

WATER WELL DRILLERS LOG

Nov 26 1982 Roy L. West Drlg WAYNE  
 date well completed firm name county well located

LANDOWNER:	description of formations encountered	from	to
<u>MRS BOB DHAUDRNL</u>			
<u>LAUREL MS</u> (mailing address)	<u>CLAY</u>	<u>3</u>	<u>18</u>
	<u>SAND</u>	<u>18</u>	<u>32</u>
	<u>CLAY</u>	<u>32</u>	<u>220</u>
	<u>SAND</u>	<u>220</u>	<u>260</u>

WELL LOCATION:  
 sec 19 T 9 N R 9 E  
7 miles SE of SANDERSVILLE  
 (distance) (direction) (nearest town)

WELL PURPOSE:  
 (home, irrigation, municipal, industrial)


- WELL COMPLETION DATA:
- (1) diameter (inches) 4"
  - (2) total depth (feet) 260'
  - (3) static water level (feet) 48' below above top of ground.
  - (4) casing PVC 250'  
 (material) (depth)
  - If telescope see back.  
 (size)
  - (5) screen 10' 250'  
 (length) (depth to top)
  - 4" PVC  
 (size) (material)
  - (6) pump 1 12  
 (HP) (yield gpm)
  - REA  
 (type power)
  - (7) electric log no  
 (yes or no)
  - (organization running log)
  - (8) how well bottom plugged WASH VALVE

DRILLERS REMARKS:

DEPT. OF NATURAL RESOURCES  
 BUREAU OF LAND & WATER RESOURCES  
 MAR 16 1984  
 RECEIVED

If well telescopes please sketch and show depths.

GROUND LEVEL

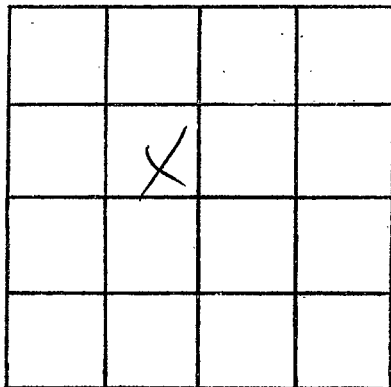

SECTION 19

Please indicate well location X.

ADDITIONAL INFORMATION

If more than one screen,  
show locations of each on sketch.