

Wayne  
F 2224

MISSISSIPPI  
BOARD OF WATER COMMISSIONERS  
416 North State Street  
Jackson, Mississippi 39201

WATER WELL DRILLERS LOG

Jan 24 1983 Roy H. West Drilling Inc Wayne  
date well completed firm name county well located


LANDOWNER: <u>Wheyses Cooley</u> <u>Waynesboro MS</u> (mailing address)	description of formations encountered	from	to
	CLAY	0	14
	SAND	14	62
	CLAY	62	76
	SAND	76	85
	CLAY	85	110
	SAND CLAY STRK	110	125
	CLAY	125	212
	limestone with clay strks.	212	290
<p>WELL LOCATION: sec. <u>21</u> T. <u>9</u> N. R. <u>9</u> E S W <u>10</u> miles <u>SE</u> of <u>SANDERSVILLE</u> (distance) (direction) (nearest town)</p> <p>WELL PURPOSE: <u>HOME</u> (home, irrigation, municipal, industrial)</p> <p>WELL COMPLETION DATA: (1) diameter (inches) <u>4"</u> (2) total depth (feet) <u>290</u> (3) static water level (feet) <u>54'</u> below above top of ground. (4) casing <u>PVC</u>, <u>213</u>, (material) (depth) <u>4"</u> (size) If telescope see back. (5) screen <u>none</u> (length) (depth to top). (size) (material) (6) pump <u>1</u> <u>23</u> (HP) (yield gpm) <u>REA</u> (type power) (7) electric log <u>no</u> (yes or no) (organization running log) (8) how well bottom plugged <u>OPEN</u></p>			
<p>DRILLERS REMARKS:</p>			

DEPT. OF NATURAL RESOURCES  
BUREAU OF LAND & WATER RESOURCES

MAR - 9 1983

RECEIVED

If well telescopes please sketch and show depths.

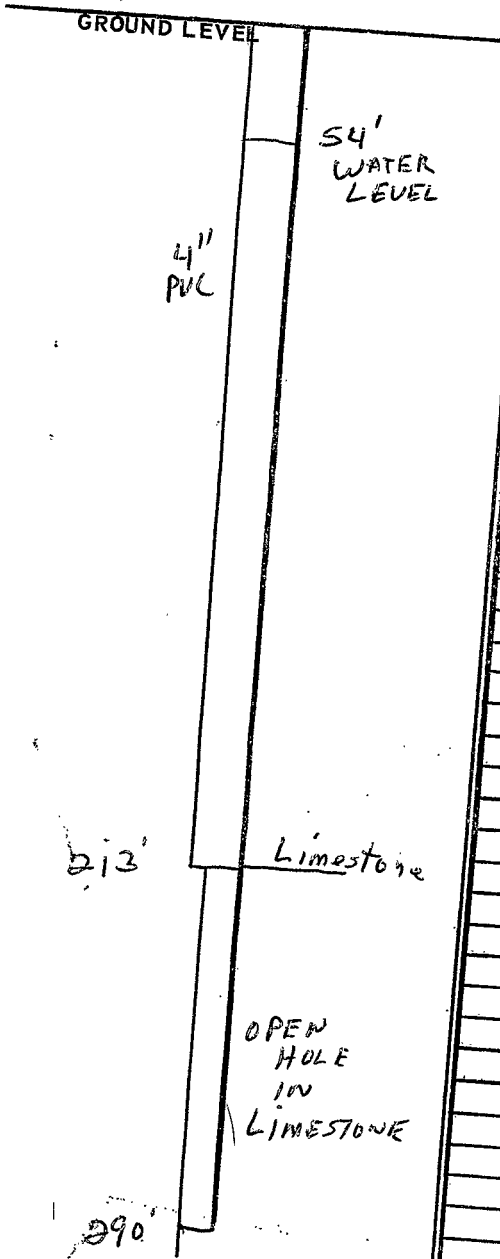

			X

SECTION 21

Please indicate well location X.

ADDITIONAL INFORMATION

If more than one screen, show locations of each on sketch.