

MISSISSIPPI DEPARTMENT OF NATURAL RESOURCES

Bureau of Land and Water Resources

Southport Mall

P.O. Box 10631

Jackson, Mississippi 39209

WATER WELL DRILLERS LOG

Wayne
F
2236

Oct 26 1983 date well completed
Proctor Drilling & Log firm name
Wayne county well located

LANDOWNER: Brownlee Const Co
Box 6 Box 227
Lavel, Miss
(mailing address)

description of formations encountered	from	to
clay & med sand	0	30
blue clay	30	46
med sand	46	53
stop on clay		

WELL LOCATION:
sec. 17 T. 9 N. R. 9 E. S. 3
4 miles SW of Quantta
(distance) (direction) (nearest town)

WELL PURPOSE: camp
(home, irrigation, municipal, industrial)

- WELL COMPLETION DATA:
- (1) diameter (inches) 2"
 - (2) total depth (feet) 53'
 - (3) static water level (feet) 20' below top of ground.
 - (4) casing P.V.C. 48'
(material) (depth)
2' if telescope see back.
(size)
 - (5) screen 5' 48'
(length) (depth to top)
2" Salt P.V.C.
(size) (material)
 - (6) pump 2 8
(HP) (yield gpm)
elec.
(type power)
 - (7) electric log no
(yes or no)
(organization running log)
 - (8) how well bottom plugged 2 sand shell

40' 1" P.V.C. log pipe

DEPT. OF NATURAL RESOURCES
BUREAU OF LAND & WATER RESOURCES


JAN 16 1984

RECEIVED

DRILLERS REMARKS:

If well telescopes please sketch and show depths.

GROUND LEVEL

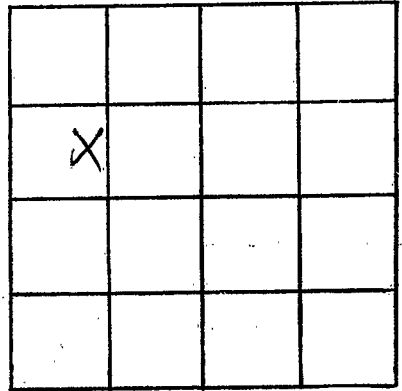

SECTION 10

Please indicate well location X.

ADDITIONAL INFORMATION

If more than one screen,
show locations of each on sketch.