

MISSISSIPPI DEPARTMENT OF NATURAL RESOURCES  
 Bureau of Land and Water Resources  
 Southport Mall  
 P.O. Box 10631  
 Jackson, Mississippi 39209  
**WATER WELL DRILLERS LOG**

Wayne  
F 2028

9-11 1984 Roy K. West Drlg WAYNE  
 date well completed firm name county well located

LANDOWNER:  
KENNEDY KEHEAY  
Waynesboro MS  
 (mailing address)

description of formations encountered	from	to
TOP SOIL	0	1
CLAY	1	14
SAND	14	18
CLAY	18	36
SAND	36	69

WELL LOCATION:  
 sec 14 T 9 N R 9 E  
4 miles S of ENCINTA  
 (distance) (direction) (nearest town)

WELL PURPOSE:  
 (home, irrigation, municipal, industrial)

- WELL COMPLETION DATA:
- diameter (inches) 2"
  - total depth (feet) 69
  - static water level (feet) 46' below top of ground.
  - casing PVC, 64'  
 (material) (depth)  
2" if telescope see back.  
 (size)
  - screen 5', 64'  
 (length) (depth to top)  
2", PVC  
 (size) (material)
  - pump 1, 12  
 (HP) (yield gpm)  
REA  
 (type power)
  - electric log NO  
 (yes or no)  
 (organization running log)
  - how well bottom plugged  
WASH VALVE

DRILLERS REMARKS:


DEPT. OF NATURAL RESOURCES  
 BUREAU OF LAND & WATER RESOURCES

OCT - 1 1984

RECEIVED

If well telescopes please sketch and show depths.

GROUND LEVEL

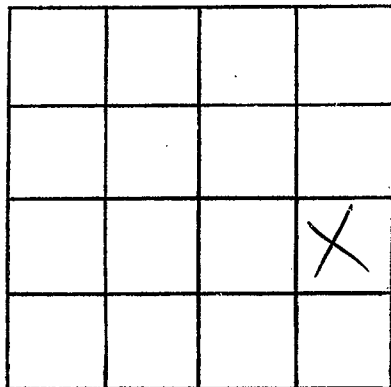

SECTION

14

Please indicate well location X.

ADDITIONAL INFORMATION

If more than one screen,  
show locations of each on sketch.