

MISSISSIPPI DEPARTMENT OF NATURAL RESOURCES

Bureau of Land and Water Resources

Southport Mall

P.O. Box 10631

Jackson, Mississippi 39209

WATER WELL DRILLERS LOG

Wayne
F
2007

10-30-1984 date well completed Roy V. West Drilling firm name WAYNE county well located

LANDOWNER:
JERRY Solis
Hiedelberg MS
 (mailing address)

description of formations encountered	from	to
CLAY	0	46
SAND	46	73
CLAY	73	101
CLAY Limestone	101	123
Limestone	123	146
Limestone strks	146	180

WELL LOCATION:
 sec. 11 T 9 N R 9 E
13 miles NW of Waynesboro
 (distance) (direction) (nearest town)

WELL PURPOSE:
 (home, irrigation, municipal, industrial)

- WELL COMPLETION DATA:
- (1) diameter (inches) 2"
 - (2) total depth (feet) 180'
 - (3) static water level (feet) 61' below above top of ground.
 - (4) casing PVC, 125'
 (material) (depth)
 (size) if telescope see back.
 - (5) screen _____
 (length) (depth to top)
 (size) (material)
 - (6) pump 1 60
 (HP) (yield gpm)
REA
 (type power)
 - (7) electric log no
 (yes or no)
 (organization running log)
 - (8) how well bottom plugged _____


DRILLERS REMARKS:

DEPT OF NATURAL RESOURCES
 BUREAU OF LAND & WATER RESOURCES

DEC-3 1984
 RECEIVED

If well telescopes please sketch and show depths.

GROUND LEVEL

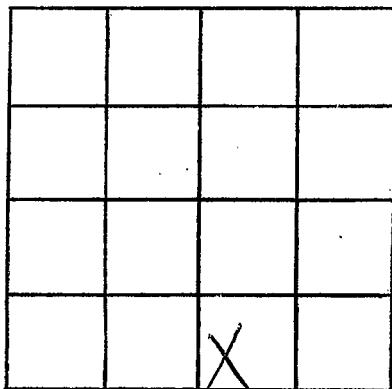

SECTION 11

Please indicate well location X.

ADDITIONAL INFORMATION

If more than one screen,
show locations of each on sketch.