

MISSISSIPPI DEPARTMENT OF NATURAL RESOURCES

Bureau of Land and Water Resources

Southport Mall

P.O. Box 10631

Jackson, Mississippi 39209

WATER WELL DRILLERS LOG

Wayne
F
2030

11-14

date well completed

84 Roy L. West Drlg

firm name

WAYNE

county well located

LANDOWNER:
MRS BANKSTON
LAUREL MS
(mailing address)

WELL LOCATION:
sec. 18 T. 9 N. R. 9 E
S W
10 miles E of LAUREL
(distance) (direction) (nearest town)

WELL PURPOSE:
(home, irrigation, municipal, industrial)

WELL COMPLETION DATA:

(1) diameter (inches) 4"

(2) total depth (feet) 246"

(3) static water level (feet) 86' below top of ground.

(4) casing PVC 233, (material) (depth)
(size) if telescope see back.

(5) screen none (length) (depth to top)
(size) (material)

(6) pump 1/2 (HP) 10 (yield gpm)
REA (type power)

(7) electric log no (yes or no)
(organization running log)

(8) how well bottom plugged WASH VALVE


description of formations encountered	from	to
CLAY	0	26
SAND	26	31
CLAY	31	48
SILT	48	51
CLAY	51	58
SAND	58	83
CLAY	83	86
SAND	86	91
CLAY	91	99
SAND	99	100
CLAY	100	108
SAND	108	116
CLAY (sand strbs)	116	135
CLAY	135	160
CLAY (Limestone strbs)	160	233
Limestone	233	246

DRILLERS REMARKS:

MISSISSIPPI DEPARTMENT OF NATURAL RESOURCES
BUREAU OF LAND & WATER RESOURCES
RECEIVED
DEC-8-1984

If well telescopes please sketch and show depths.

GROUND LEVEL

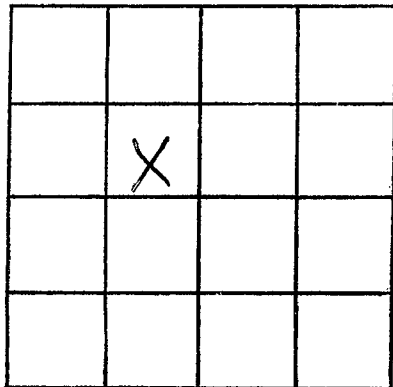

SECTION 18

Please indicate well location X.

ADDITIONAL INFORMATION

If more than one screen,
show locations of each on sketch.