

MISSISSIPPI DEPARTMENT OF ENVIRONMENTAL QUALITY

Office of Land and Water Resources

P. O. Box 10631
Jackson, MS 39289-0631
WATER WELL DRILLERS LOG

COUNTY WELL LOCATED <u>Wayne</u>	
WELL NUMBER <u>T2041</u>	CODED
DATE WELL COMPLETED	

PERMIT NUMBER
NAME OF DRILLING FIRM <u>Roy V. West</u>

NAME & MAILING ADDRESS OF LANDOWNER <u>Bobby Pryor</u>		
<u>Rt 13 Box 172</u>		
<u>Laurel MS</u>		
WELL LOCATION: SEC	TOWNSHIP	RANGE
<u>28</u>	<u>9 N</u>	<u>9 W</u>
DISTANCE	DIRECTION	NEAREST TOWN
<u>12</u> Miles	<u>E</u>	of <u>LAUREL</u>
OTHER LANDMARK		
WELL PURPOSE: Home, Irrigation, Municipal, Industrial, Fish Pond, etc. <u>Poultry Farm</u>		

PUMP DATA		
PUMP TYPE (Circle One): <u>Submersible</u> Turbine, Jet, Flowing Well, Other (Describe) _____		
POWER TYPE (Circle One): <u>Electric</u> , Tractor, Diesel, Gasoline, Butane, Other (Describe) _____ H/P <u>1</u>		
Pump Capacity (GPM) <u>20</u>	No. of Stages	Setting Depth <u>120</u> FT.
PUMP TEST		
Well yielded _____ GPM with a drawdown of _____ ft. after _____ hours of pumping		

WELL DATA		
Well Depth <u>250</u>	Casing Diameter (In.) <u>4</u>	Casing Length (Ft.) <u>222</u>
Type of Casing <u>Pvc</u>	Hole Depth <u>250</u>	Depth to Static Water Level <u>20</u>
TYPE OF COMPLETION: (Circle One or More): Gravel Packed, Underreamed, Telescoped, Natural Development, <u>Open Hole</u> , Other		

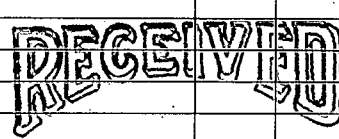
LOG DATA	
TYPE OF LOG RUN (Circle One): Electric, Gamma Ray, Density, Sonic, <u>No Log Run</u> , Neutron, Other (Describe) _____	
Name of Organization Running Log	

WELL GROUTED TO A DEPTH OF <u>15</u> FEET Type Grout (circle one): Cement, Bentonite, or Mix

GEOLOGIC DATA (Office Use Only)			
Surface Elev.	Geologic Unit	Unit Thickness	Depth to Top.
Subs. SWL	Date	Analysis	Aquifer Test
Driller's Remarks			

SCREEN DATA		
Diameter - Inches	Length - Feet	Slot Size - Inches
Screen Type		Depth to Bottom - Feet

DESCRIPTION OF FORMATIONS ENCOUNTERED	FROM	TO
<u>CLAY</u>	<u>0</u>	<u>18</u>
<u>SAND</u>	<u>18</u>	<u>52</u>
<u>CLAY</u>	<u>52</u>	<u>187</u>
<u>CLAY ROCK STRKS</u>	<u>187</u>	<u>220</u>
<u>ROCK</u>	<u>220</u>	<u>231</u>
<u>ROCK CLAY STRS</u>	<u>231</u>	<u>250</u>

FORMATIONS (Continued)	FROM	TO
 <u>DEC 23 1993</u>		
Dept. of Environmental Quality Office of Land & Water Resources		
IF MORE SPACE IS NEEDED, USE BACK		

If well telescopes please sketch and show depths.

GROUND LEVEL

		X	

SECTION 28

Please indicate well location X.

ADDITIONAL INFORMATION

If more than one screen,
show location of each on sketch.