




If well telescopes please sketch and show depths.

GROUND LEVEL

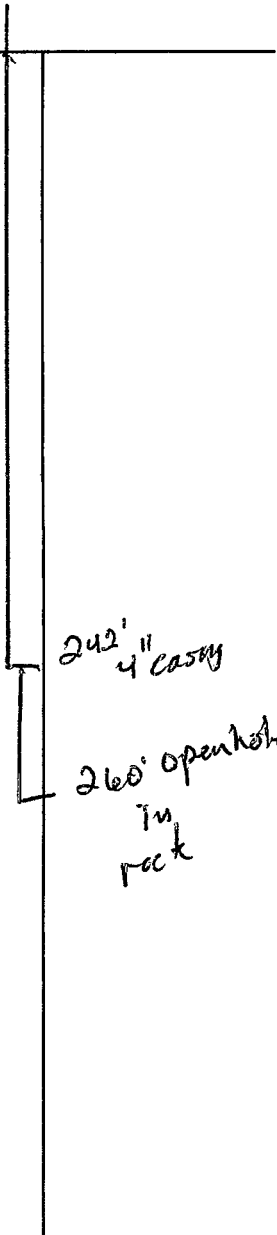

242' 4" casing

260' open hole  
in  
rock

	X		

SECTION \_\_\_\_\_

Please indicate well location X.

ADDITIONAL INFORMATION

If more than one screen,  
show location of each on sketch.