

G6
5-27-64

WATER WELL DRILLERS LOG

Date: May 27, 1964, Driller: Porter Drilling & Log Co. Wayne
3P (Name)

(1) Owner of Land: B. B. Inelgrove
(Name)
Rt 1 Shubuta
(Address)

(2) Location: NW 1/4, NW 1/4, Sec. 22 T. 9 R. 2
10 miles NW of Waynesburg
(distance) (direction) (Nearest Town)

(3) Topography: Hilly
(Hilly) (Flat) (Level)

(4) Purpose of Well: domestic
(Domestic Irrigation
Municipal, Industrial, Other)

Description & Color of Materials Sand, Clay, Red Clay, Shell, etc.	Thick- ness Feet	Depth Feet
<u>red clay</u>	<u>8</u>	<u>8</u>
<u>chalk</u>	<u>7</u>	<u>15</u>
<u>sand & chalk</u>	<u>29</u>	<u>44</u>
<u>course sand & peaguel</u>	<u>21</u>	<u>65</u>
<u>course red sand</u>	<u>4</u>	<u>69</u>
<u>stop on chalk</u>		

Information upon completion of well:

(1) Diameter 2" inches.

(2) Total Depth 64' feet.

(3) Water Level 27' feet below top of ground.

(4) Cased to 59', Size 2"


(5) Screen: Size 1 1/4", Length 5'
Johnson S.S.

(6) Were any formations sealed against pollution?
X yes, X no.

If YES depth of formation _____

Why _____

Drillers Remarks: Jet pump

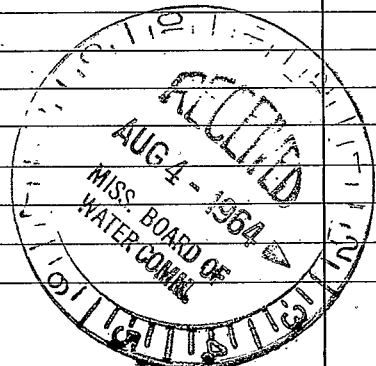

(Use Back Side)

Well No.

