

G8

2-12-64

WATER WELL DRILLERS LOG

Date: Feb. 12, 1964, Driller: Porter Drilling & Sup. County: Wayne
 3P (Name)

(1) Owner of Land: Louis Kelly Eider
 (Name)
 Rt 1 Shubuta
 (Address)

(2) Location: NE 1/4, SW 1/4, Sec 20 T9 R8,
 12 miles west of Hainesboro,
 (direction) (Nearest Town)

(3) Topography: Hilly
 (Hilly) (Flat) (Level)

(4) Purpose of Well: domestic
 (Domestic Irrigation
 Municipal, Industrial, Other)

Description & Color of Materials Sand, Clay, Red Clay, Shell, etc.	Thick- ness Feet	Depth Feet
med clay	6	6
yellow chalk	8	14
chalk	29	43
sand	15	58
chalk	77	135
thin rock		135
sand fine to med.	53	188
blue chalk	19	207
strata of rock & chalk	35	242
blue chalk	36	278
long gone rock	25	303
white chalk	9	312

Information upon completion of well:

(1) Diameter 2' inches.

(2) Total Depth 312' feet.

(3) Water Level 118' feet below top of ground.

(4) Cased to 278', Size 2"


(5) Screen: Size none, Length _____

(6) Were any formations sealed against pollution?
 _____ yes, no.

If YES depth of formation _____

Why _____

Drillers Remarks: _____

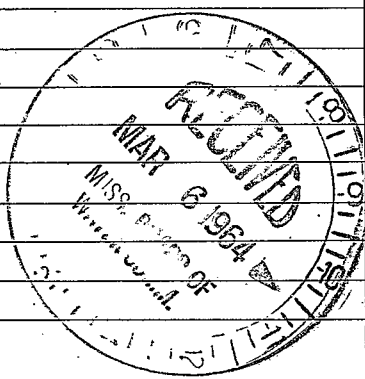

(Use Back Side)

Well No.

