

G 9

12-19-63

WATER WELL DRILLERS LOG

Date: Dec 19, 1963, Driller: Porter Drilling & Log County Wayne
 3P (Name)

(1) Owner of Land: Carol Williams
 (Name)
Art Shubuta, Miss
 (Address)
 (2) Location: NW 1/4, SE 1/4, Sec. 15 T 9 R 8,
11 miles NW of Waynesboro
 (distance) (direction) (Nearest Town)
 (3) Topography: hilly
 (Hilly) (flat) (Level)
 (4) Purpose of Well: Domestic
 (Domestic Irrigation
 Municipal, Industrial, Other)


Description & Color of Materials Sand, Clay, Red Clay, Shell, etc.	Thick- ness Feet	Depth Feet
<u>red clay</u>	<u>8</u>	<u>8</u>
<u>chalk</u>	<u>4</u>	<u>12</u>
<u>streak sand & chalk</u>	<u>9</u>	<u>21</u>
<u>course red sand & peagood</u>	<u>7</u>	<u>28</u>
<u>red chalk</u>	<u>3</u>	<u>31</u>
<u>blue chalk</u>	<u>31</u>	<u>62</u>
<u>strata of rock & chalk</u>	<u>12</u>	<u>74</u>
<u>blue chalk</u>	<u>4</u>	<u>78</u>
<u>gray sand mixed with</u>		
<u>chalk will not produce</u>	<u>7</u>	<u>85</u>
<u>blue chalk</u>	<u>29</u>	<u>114</u>
<u>honey cone rock</u>	<u>20</u>	<u>134</u>
<u>white chalk</u>	<u>8</u>	<u>142</u>

Information upon completion of well:

(1) Diameter 2" inches.
 (2) Total Depth 142' feet.
 (3) Water Level 45' feet below top of ground.
 (4) Cased to 114', Size 2"
 (5) Screen: Size none, Length _____
 (6) Were any formations sealed against pollution?
 _____ yes, X no.

If YES depth of formation _____
 Why _____

Drillers Remarks: Open hole

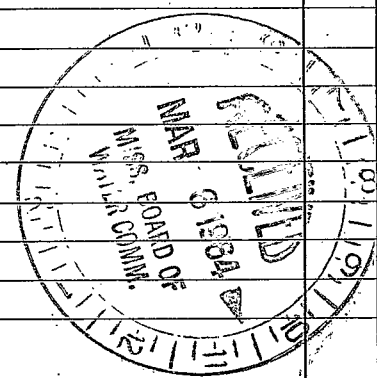

(Use Back Side)

Well No.

