

WAYNE

G 15³

WATER WELL DRILLERS LOG G-300

Date: Sept 30, 1960, Driller: D. N. Porter & Son County Wayne

9-3-60

4P

(Name)

(1) Owner of Land: Ed Gatten
(Name)

At 1 Hazenboro Miss
(Address)

(2) Location: 1/4, 1/4, Sec. 11 T 9 R 8

12 miles N. 24, of Hazenboro
(distance) (direction) (Nearest Town)

(3) Topography: Hilly
(Hilly) (High) (Level)

(4) Purpose of Well: domestic
(Domestic Irrigation, Municipal, Industrial, Other)

Description & Color of Materials Sand, Clay, Red Clay, Shell, etc.	Thick- ness Feet	Depth Feet
clay	20	20'
sand	40	60'
blue chert	28	88'
lime rock	15	103'
# blue chert	32	135'
lime honeycombed rock	35	170'
blue chert	10	180'

Information upon completion of well:

(1) Diameter 2" inches.

(2) Total Depth 180' feet.

(3) Water Level 90' feet below top of ground.

(4) Cased to 135', Size 2"


(5) Screen: Size no screen, Length _____

(6) Were any formations sealed against pollution?
_____ yes, no.

If YES depth of formation _____

Why _____

Drillers Remarks: _____

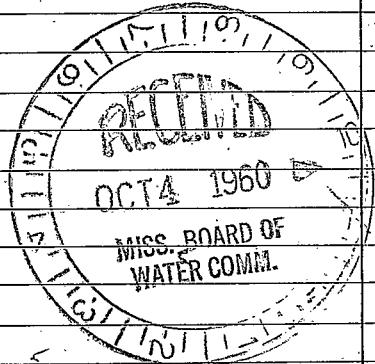

(Use Back Side)

Well No.

