

WAYNE MISSISSIPPI BOARD OF WATER COMMISSIONERS

G 16
5-15-61

WATER WELL DRILLERS LOG

A 303

Date: May 15, 1961, Driller: S. M. Porterson County Wayne
3 P (Name)


	Description & Color of Materials Sand, Clay, Red Clay, Shell, etc.	Thick- ness Feet	Depth Feet
(1) Owner of Land: <u>C. W. Williams</u> (Name) <u>At 1 Shubuta, Miss.</u> (Address)	<u>clay</u>	<u>20</u>	<u>20'</u>
(2) Location: <u>SW 1/4, NE 1/4, Sec. 16 T9R8</u> <u>11 miles NW</u> of <u>Waynesboro</u> (distance) (direction) (Nearest Town)	<u>sand & chalk</u>	<u>20</u>	<u>40'</u>
(3) Topography: <u>hilly</u> (Hilly) (Flat) (Level)	<u>sand</u>	<u>17</u>	<u>51</u>
(4) Purpose of Well: <u>domestic</u> (Domestic Irrigation Municipal, Industrial, Other)			

Information upon completion of well:

- (1) Diameter 2" inches.
- (2) Total Depth 51' feet.
- (3) Water Level 30' feet below top of ground.
- (4) Cased to 45', Size 2"
- (5) Screen: Size 1 1/4", Length 6'
- (6) Were any formations sealed against pollution?
no

If YES depth of formation _____
Why _____

Drillers Remarks: _____

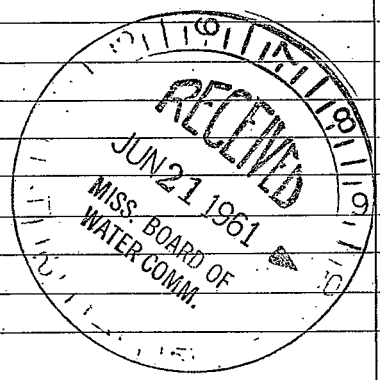

(Use Back Side)

Well No.

