

WAYNE MISSISSIPPI BOARD OF WATER COMMISSIONERS

G 17  
9-1-61

WATER WELL DRILLERS LOG

G

Date: Sept 1, 1961; Driller: D. N. Porter Ion County Wayne  
3P (Name)

(1) Owner of Land: Wayne County  
(Name) School Sys  
Waynesboro, Miss  
(Address)

(2) Location: SE 1/4, SE 1/4, Sec. 32 T9R8  
9 miles west, of Waynesboro  
(distance) (direction) (Nearest Town)

(3) Topography: hilly  
(Hilly) (Flat) (Level)

(4) Purpose of Well: school  
(Domestic Irrigation  
Municipal, Industrial, Other)

Description & Color of Materials Sand, Clay, Red Clay, Shell, etc.	Thick- ness Feet	Depth Feet
<u>red clay</u>	<u>30</u>	<u>30</u>
<u>sand with chalk</u>	<u>40</u>	<u>70</u>
<u>clean sand</u>	<u>10</u>	<u>80</u>
<u>course sand with liquid chalk</u>	<u>10</u>	<u>90</u>
<u>clean course sand</u>	<u>12</u>	<u>102</u>
<u>chalk</u>	<u>3</u>	<u>105</u>
<u>sand</u>	<u>20</u>	<u>125</u>
<u>chalk</u>	<u>2</u>	<u>127</u>


Information upon completion of well:

- (1) Diameter 6" inches.
- (2) Total Depth 127' feet.
- (3) Water Level 55 feet below top of ground.
- (4) Cased to 103'4", Size 6"
- (5) Screen: Size 6", Length 21'6"
- (6) Were any formations sealed against pollution?  
\_\_\_\_\_ yes, X no.

If YES depth of formation \_\_\_\_\_

Why \_\_\_\_\_

Drillers Remarks: \_\_\_\_\_

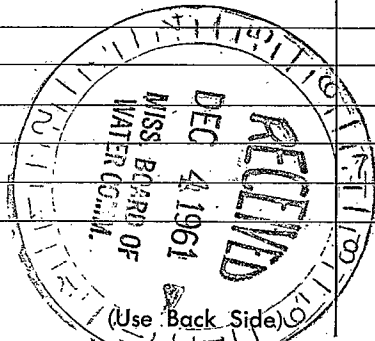

Well No. \_\_\_\_\_

8