

WAYNE MISSISSIPPI BOARD OF WATER COMMISSIONERS

G 20

3-1-62

WATER WELL DRILLERS LOG


Date: March 1, 1962, Driller Porter Drilling & Sup. County Wayne
 (Name)
 3P

(1) Owner of Land:	Description & Color of Materials Sand, Clay, Red Clay, Shell, etc.	Thick- ness Feet	Depth Feet
<u>Bob West</u> (Name) <u>Rt 1 Waynesboro, Miss</u> Address	<u>red clay with gravel</u>	<u>25</u>	<u>25</u>
(2) Location: <u>NW 1/4, NW 1/4, Sec 25 T 9 R 8</u> <u>6</u> miles <u>NW</u> of <u>Waynesboro</u> (distance) (direction) (Nearest Town)	<u>fine bed sand</u>	<u>15</u>	<u>40</u>
(3) Topography: <u>Hilly</u> (Hilly) (Flat) (Level)	<u>medium red sand</u>	<u>7</u>	<u>47</u>
(4) Purpose of Well: <u>Domestic</u> (Domestic Irrigation Municipal, Industrial, Other)	<u>stop on chalk</u>		

Information upon completion of well:

- (1) Diameter 2" inches.
- (2) Total Depth 47' feet.
- (3) Water Level 33' feet below top of ground.
- (4) Cased to 42', Size 2"
- (5) Screen: Size 1 1/4", Length 5'
Johnson S.S.
- (6) Were any formations sealed against pollution?
 yes, no.

If YES depth of formation _____
 Why _____
 Drillers Remarks: _____

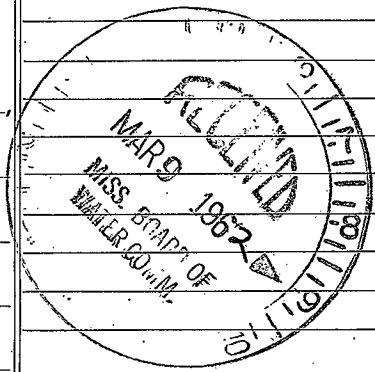

(Use Back Side)

Well No.

