

G21

5-8-62

WATER WELL DRILLERS LOG

Date: May 8, 1962, Driller: Porters Drilling & Pump Co., County: Wayne
3P (Name)

(1) Owner of Land: <u>J. L. Langley Jr.</u> (Name)	Description & Color of Materials Sand, Clay, Red Clay, Shell, etc.	Thick- ness Feet	Depth Feet
<u>Rt 1 Waynesboro</u> (Address)	<u>red clay</u>	12	12
(2) Location: <u>NW 1/4, NW 1/4, Sec 25 T9R8</u>	<u>sand & chert</u>	18	30
<u>8</u> miles <u>NW</u> of <u>Waynesboro</u> (distance) (direction) (Nearest Town)	<u>course sand with some chert</u>	6	36
(3) Topography: <u>hilly</u> (Hilly) (Flat) (Level)			
(4) Purpose of Well: <u>domestic</u> (Domestic Irrigation Municipal, Industrial, Other)			

Information upon completion of well:


- (1) Diameter 1 1/4" inches.
- (2) Total Depth 36' feet.
- (3) Water Level 12' feet below top of ground.
- (4) Cased to 31, Size 1 1/4
- (5) Screen: Size 1 1/4, Length 5'
- (6) Were any formations sealed against pollution?

yes, no.

If YES depth of formation _____

Why _____

Drillers Remarks: _____

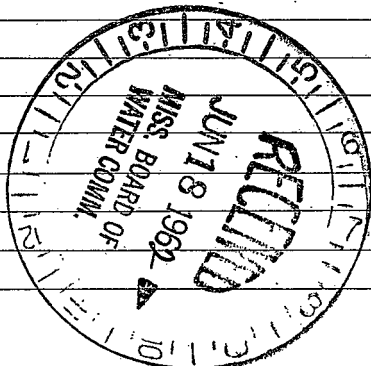

(Use Back Side)

Well No.

