

WAYNE MISSISSIPPI BOARD OF WATER COMMISSIONERS

G 23

6-28-62

WATER WELL DRILLERS LOG

Date: June 28, 1962, Driller: Porter Drilling & Log County: Wayne
 3P (Name)

(1) Owner of Land: <u>Mrs. O. R. Reynolds</u> (Name)	Description & Color of Materials Sand, Clay, Red Clay, Shell, etc.	Thick- ness Feet	Depth Feet
<u>At 1 Shubuta, Miss.</u> (Address)	<u>red clay</u>	<u>10</u>	<u>10'</u>
(2) Location: <u>SE 1/4, NW 1/4, Sec. 6 T. 9 R. 8</u>	<u>blue chalk</u>	<u>10</u>	<u>20'</u>
<u>17 miles NW of Natchez</u> (distance) (direction) (Nearest Town)	<u>strata of red chalk & blue</u>	<u>70</u>	<u>90</u>
(3) Topography: <u>hilly</u> (Hilly) (Flat) (Level)	<u>fine sand & chalk</u>	<u>39</u>	<u>129</u>
(4) Purpose of Well: <u>domestic</u> (Domestic Irrigation Municipal, Industrial, Other)	<u>blue chalk</u>	<u>16</u>	<u>145</u>
	<u>lime rock</u>	<u>15</u>	<u>160</u>
	<u>blue chalk</u>	<u>34</u>	<u>194</u>
	<u>lime rock</u>	<u>4</u>	<u>198</u>
	<u>limestone rocks</u>	<u>22</u>	<u>220</u>
	<u>white chalk & rock</u>	<u>22</u>	<u>242</u>

Information upon completion of well:

- (1) Diameter 2" inches.
- (2) Total Depth 243' feet.
- (3) Water Level 102 feet below top of ground.
- (4) Cased to 194', Size 2"
- (5) Screen: Size none, Length _____
- (6) Were any formations sealed against pollution?


yes, no.

If YES depth of formation 194

Why _____

Drillers Remarks: sealed with

3 1/2" collar on 2" casing
set on rock

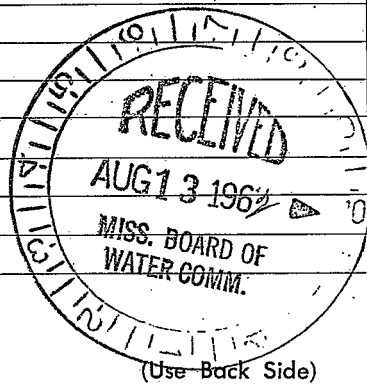

Well No.

