

G 24  
7-19-62

WATER WELL DRILLERS LOG


Date: July 19, 1962, Driller: Porter Drilling & Log County Wayne  
3P (Name)

|   |   |                        |               |
|---|---|------------------------|---------------|
| (1) Owner of Land: <u>A. L. Boykin</u><br>(Name)<br><u>At 1 Shubuta, Miss.</u><br>(Address)   | Description & Color of Materials<br>Sand, Clay, Red Clay, Shell, etc. | Thick-<br>ness<br>Feet | Depth<br>Feet |
| (2) Location: <u>SE 1/4, NW 1/4, Sec. 2 T. 9 R. 8 E.</u><br><u>12</u> miles <u>NW</u> of <u>Waynesboro</u><br>(distance) (direction) (Nearest Town) | <u>sandy clay</u>   | <u>15</u>              | <u>15</u>     |
| (3) Topography: <u>Hilly</u><br>(Hilly) (Flat) (Level)  | <u>cherty sand</u>  | <u>20</u>              | <u>35</u>     |
| (4) Purpose of Well: <u>domestic</u><br>(Domestic Irrigation<br>Municipal, Industrial, Other)   | <u>blue chalk</u>   | <u>63</u>              | <u>98</u>     |
|   | <u>lime rock</u>  | <u>4</u>               | <u>102</u>    |
|   | <u>honeycomb rock</u>   | <u>20</u>              | <u>122</u>    |
|   | <u>white chalk &amp; rock</u>   | <u>10</u>              | <u>132</u>    |

Information upon completion of well:

- (1) Diameter 2" inches.
- (2) Total Depth 132 feet.
- (3) Water Level 67' feet below top of ground.
- (4) Cased to 102, Size 2"
- (5) Screen: Size none, Length \_\_\_\_\_
- (6) Were any formations sealed against pollution?  
X yes, \_\_\_\_\_ no.

If YES depth of formation 4" bushing  
Why set on rock at 102'  
Drillers Remarks: open hole below  
in honeycomb rock

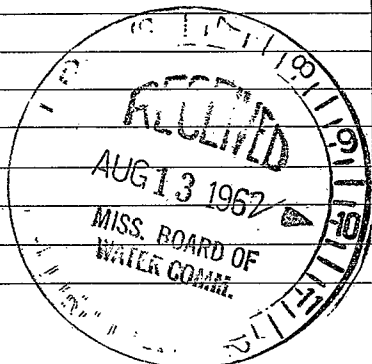

(Use Back Side)

Well No.

