

WAYNE

MISSISSIPPI BOARD OF WATER COMMISSIONERS

G25

7-30-62

WATER WELL DRILLERS LOG

Date: July 30, 1962, Driller: Porter Drilling & Pump Co., Inc. (Name) 3P. County: Wayne

(1) Owner of Land:	Description & Color of Materials	Thick-ness Feet	Depth Feet
Mrs Robert Daniels (Name)	Sand, Clay, Red Clay, Shell, etc.		
Pt 1 Shubuta, Miss. (Address)	red sandy clay	18	18
Location: NE 1/4, SW 1/4, Sec. 1 T9R8	course dry sand	22	40
11 miles N.W. of Waynesboro (distance) (direction) (Nearest Town)	hard iron chert	1	41
(3) Topography: hilly (Hilly) (Flat) (Level)	sand mixed chert	41	82
(4) Purpose of Well: domestic (Domestic Irrigation, Municipal, Industrial, Other)	course sand	19	101
	stagnant white shell		
	in sand		


Information upon completion of well:

- (1) Diameter 2" inches.
- (2) Total Depth 101 feet.
- (3) Water Level 8' feet below top of ground.
- (4) Cased to 95, Size 2"
- (5) Screen: Size 1/4, Length 6'
- (6) Were any formations sealed against pollution?
 yes, no.

If YES depth of formation _____

Why _____

Drillers Remarks: _____

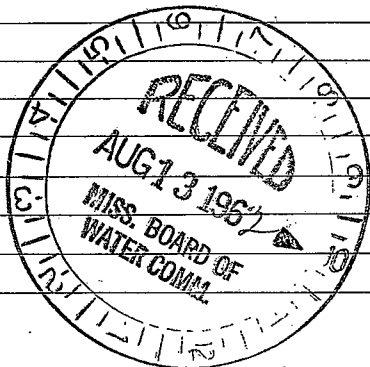

(Use Back Side)

Well No.

