

WAYNE MISSISSIPPI BOARD OF WATER COMMISSIONERS

G 27

8-23-62

WATER WELL DRILLERS LOG

Date: Aug 23, 19 62, Driller: Porter Drilling & Sup. Co. Wayne
 3P (Name)

(1) Owner of Land:	Description & Color of Materials Sand, Clay, Red Clay, Shell, etc.	Thick- ness Feet	Depth Feet
<u>Miss. State Hi. Dept.</u> (Name)	<u>red clay</u>	<u>6'</u>	<u>6'</u>
<u>Kathieburg Miss</u> (Address)	<u>gravel & sand</u>	<u>42</u>	<u>48'</u>
(2) Location: <u>NE 1/4, SE 1/4, Sec. 24 T 9 R 8</u>			
<u>7</u> miles <u>N.W.</u> of <u>Waynesboro</u> (distance) (direction) (Nearest Town)			
(3) Topography: <u>hilly</u> (Hilly) (flat) (Level)			
(4) Purpose of Well: <u>Commercial</u> (Domestic Irrigation Municipal, Industrial, Other)			


Information upon completion of well:

- (1) Diameter 2" inches.
- (2) Total Depth 48 feet.
- (3) Water Level 12' feet below top of ground.
- (4) Cased to 42', Size 2"
- (5) Screen: Size 1/4", Length 6'
- (6) Were any formations sealed against pollution?
 yes, no.

If YES depth of formation _____

Why _____

Drillers Remarks: _____

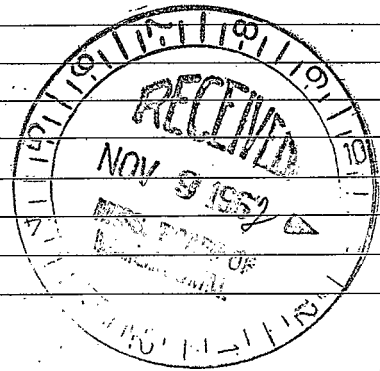

(Use Back Side)

Well No.

