

G 28

8-23-62

WATER WELL DRILLERS LOG

Date: Aug 23, 1962, Driller: Porter Drilling & Pipe County Wayne
 (Name)

(1) Owner of Land: <u>Miss State Highway Dept</u> (Name)	Description & Color of Materials Sand, Clay, Red Clay, Shell, etc.	Thick- ness Feet	Depth Feet
<u>Kathisburg, Miss.</u> (Address)	<u>red clay</u> <u>gravel & sand</u>	6'	6'
(2) Location: <u>NE 1/4, SE 1/4, Sec. 26 T9 R8,</u> <u>7</u> miles <u>N.W.</u> of <u>Waynesboro</u> (distance) (direction) (Nearest Town)			
(3) Topography: <u>hilly</u> (Hilly) (Flat) (Level)			
(4) Purpose of Well: <u>Commercial</u> (Domestic Irrigation Municipal, Industrial, Other)			


Information upon completion of well:

- (1) Diameter 2" inches.
- (2) Total Depth 46 1/2 feet.
- (3) Water Level 12' feet below top of ground.
- (4) Cased to 40 1/2', Size 2"
- (5) Screen: Size 6', Length 1 1/4"
- (6) Were any formations sealed against pollution?
 yes, no.

If YES depth of formation _____

Why _____

Drillers Remarks: _____

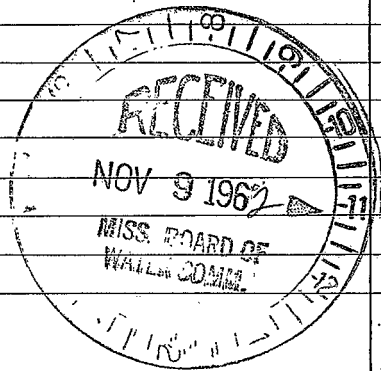

(Use Back Side)

Well No.

