

G30

5-25-64

WATER WELL DRILLERS LOG

Date: May 25, 1964, Driller: Booth Drilling & Log County Wayne
 3P (Name)

(1) Owner of Land Earl Jordan
 (Name)
Rt 1 Nagsboro, Miss
 (Address)
 (2) Location: NW 1/4, NW 1/4, Sec. 34 T9 R8
9 miles west, of Nagsboro
 (distance) (direction) (Nearest Town)
 (3) Topography: hilly
 (Hilly) (Flat) (Level)
 (4) Purpose of Well: domestic
 (Domestic Irrigation
 Municipal, Industrial, Other)


Description & Color of Materials Sand, Clay, Red Clay, Shell, etc.	Thick- ness Feet	Depth Feet
<u>red clay</u>	<u>6</u>	<u>6</u>
<u>Chalk</u>	<u>9</u>	<u>15</u>
<u>red sand</u>	<u>4</u>	<u>19</u>
<u>white chalk</u>	<u>12</u>	<u>31</u>
<u>sand</u>	<u>13</u>	<u>44</u>
<u>sand & chalk</u>	<u>4</u>	<u>48</u>
<u>Chalk</u>	<u>9</u>	<u>57</u>
<u>med sand</u>	<u>10</u>	<u>67</u>
<u>stopped while still in sand</u>		

Information upon completion of well:

(1) Diameter 2" inches.
 (2) Total Depth 67' feet.
 (3) Water Level 35' feet below top of ground.
 (4) Cased to 60', Size 2"
 (5) Screen: Size 1 1/4", Length 6'
80 ga
 (6) Were any formations sealed against pollution?
yes, no.

If YES depth of formation _____
 Why _____

Drillers Remarks: _____

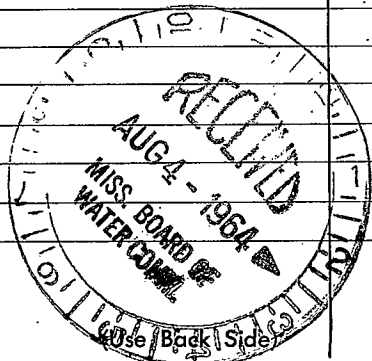

Well No.

100

100