

WAYNE MISSISSIPPI BOARD OF WATER COMMISSIONERS

G31

8-5-64

WATER WELL DRILLERS LOG

Date Aug 5, 1964, Driller: Porter Drilling & Supply Co. Inc. Wayne
 3P (Name)

(1) Owner of Land: <u>Robert L. Graham</u> (Name)	Description & Color of Materials Sand, Clay, Red Clay, Shell, etc.	Thick- ness Feet	Depth Feet
<u>Box 1 Shubuta</u> (Address)	<u>red clay</u>	17	17
(2) Location: <u>NE 1/4, SE 1/4, Sec. 12, T. 9 R. 8</u>	<u>red sand to gray gravel</u>	3	20
<u>12</u> miles <u>NW</u> , of <u>Waynesboro</u> (distance) (direction) (Nearest Town)	<u>red sand</u>	20	40
(3) Topography: <u>hilly</u> (Hilly) (Flat) (Level)	<u>red sand & chalk "dry"</u>	9	49
(4) Purpose of Well: <u>domestic</u> (Domestic Irrigation Municipal, Industrial, Other)	<u>blue chalk</u>	13	62
	<u>rock stratas</u>	8	70
	<u>blue chalk</u>	41	111'
	<u>red lined hole to 37 1/2" at</u>	111'	
	<u>honey cone rock</u>	20	131'
	<u>white chalk</u>	9	140'


Information upon completion of well:

- (1) Diameter 2" inches.
- (2) Total Depth 140' feet.
- (3) Water Level 92 feet below top of ground.
- (4) Cased to 111', Size 2"
- (5) Screen: Size none, Length _____
- (6) Were any formations sealed against pollution?
 _____ yes, X no.

If YES depth of formation _____

Why _____

Drillers Remarks: _____

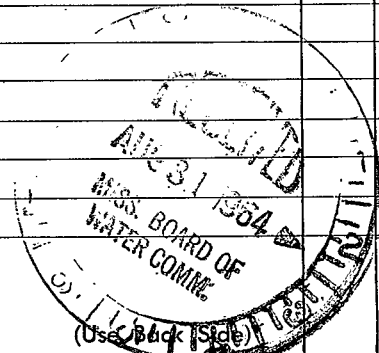

Well No. _____

(Use Back Side)

