

WAYNE
G32
8-14-64

MISSISSIPPI BOARD OF WATER COMMISSIONERS

WATER WELL DRILLERS LOG

Date: Aug 14, 1964, Driller: Porter Drilling & Pump County Wayne
3P (Name)

(1) Owner of Land: <u>Mr Lura Sumrell</u> (Name)	Description & Color of Materials Sand, Clay, Red Clay, Shell, etc.	Thick- ness Feet	Depth Feet
<u>RT 1 Waynesboro Miss</u> (Address)	<u>red clay</u>	6	6
(2) Location: <u>SW 1/4, SW 1/4, Sec. 24 T9 R8</u>	<u>sand</u>	10	16
<u>8</u> miles <u>NW</u> of <u>Waynesboro</u> (distance) (direction) (Nearest Town)	<u>clay</u>	6	22
(3) Topography: <u>Hilly</u> (Hilly) (Flat) (Level)	<u>clean sand</u>	10	32
(4) Purpose of Well: <u>domestic</u> (Domestic Irrigation Municipal, Industrial, Other)	<u>chalk & sand</u>	6	38
	<u>white chalk</u>	2	40
	<u>red sand</u>	13	53
	<u>stopped while still in sand</u>		


Information upon completion of well:

- (1) Diameter 2" inches.
- (2) Total Depth 53' feet.
- (3) Water Level 25 feet below top of ground.
- (4) Cased to 47', Size 2".
- (5) Screen: Size 1 1/4", Length 5'.
Johnson SS. - 8 slot
- (6) Were any formations sealed against pollution?
no.

If YES depth of formation _____

Why _____

Drillers Remarks: _____

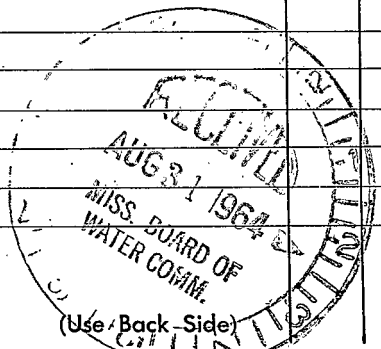

Well No. _____

(Use Back Side)

