

WAYNE MISSISSIPPI BOARD OF WATER COMMISSIONERS

G 33

11-17-64

WATER WELL DRILLERS LOG

Date: Nov 17, 1964, Driller: Dexter Dilling Wayne County
 3P (Name)

(1) Owner of Land: Lee Street
 (Name)
At 1 Shubuta, Miss.
 (Address)

(2) Location: NE 1/4, NE 1/4, Sec 21 T9 R8,
10 miles NW of Waynesboro,
 (distance) (direction) (Nearest Town)

(3) Topography: Hilly
 (Hilly) (Flat) (Level)

(4) Purpose of Well:
 (Domestic Irrigation
 Municipal, Industrial, Other)

Description & Color of Materials Sand, Clay, Red Clay, Shell, etc.	Thick- ness Feet	Depth Feet
<u>red clay</u>	<u>10</u>	<u>10</u>
<u>sand</u>	<u>2</u>	<u>12</u>
<u>red chalk</u>	<u>2</u>	<u>14</u>
<u>blue chalk</u>	<u>3</u>	<u>17</u>
<u>red chalk</u>	<u>13</u>	<u>30</u>
<u>white chalk</u>	<u>28</u>	<u>58</u>
<u>fine sand</u>	<u>7</u>	<u>65</u>
<u>med sand</u>	<u>13</u>	<u>78</u>

Information upon completion of well:

(1) Diameter 2" inches.

(2) Total Depth 78' feet.

(3) Water Level 49' feet below top of ground.

(4) Cased to 68', Size 2"


(5) Screen: Size 1 1/4", Length 5'
Johnson, S. S.

(6) Were any formations sealed against pollution?
Plot
 _____ yes, X no.

If YES depth of formation _____

Why _____

Drillers Remarks: _____

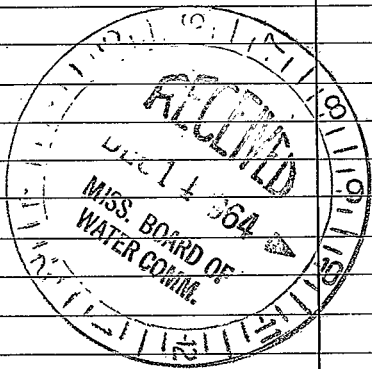

(Use Back Side)

Well No.

