

WAYNE MISSISSIPPI BOARD OF WATER COMMISSIONERS

G34

2-25-65

WATER WELL DRILLERS LOG

Date Feb 25, 1965, Driller: Porter Drilling & Log County Wayne
 3P (Name)

	Description & Color of Materials Sand, Clay, Red Clay, Shell, etc.	Thick- ness Feet	Depth Feet
(1) Owner of Land: <u>Lenard Street</u> (Name) <u>At 1 Shubuta Miss</u> (Address)	<u>red clay</u>	<u>10</u>	<u>10</u>
(2) Location: <u>NE 1/4, NW 1/4, Sec. 21 T. 9. R. 8.</u>	<u>sand</u>	<u>12</u>	<u>22</u>
<u>10</u> miles <u>NW</u> of <u>Waynesboro</u> (distance) (direction) (Nearest Town)	<u>Chalk</u>	<u>38</u>	<u>60</u>
(3) Topography: <u>hilly</u> (Hilly) (Flat) (Level)	<u>thin pack at 28'</u>		
(4) Purpose of Well: <u>domestic</u> (Domestic Irrigation Municipal, Industrial, Other)	<u>sand & chalk</u>	<u>8</u>	<u>68</u>
	<u>red coarse sand with</u>		
	<u>red streaks</u>	<u>15</u>	<u>83</u>
	<u>stopped while still</u>		
	<u>in sand</u>		


Information upon completion of well:

- (1) Diameter 2" inches.
- (2) Total Depth 83' feet.
- (3) Water Level 52' feet below top of ground.
- (4) Cased to 73', Size 2"
- (5) Screen: Size 1/4", Length 5'
Johnson S.S.
- (6) Were any formations sealed against pollution?
 yes, no.

If YES depth of formation _____

Why _____

Drillers Remarks: _____

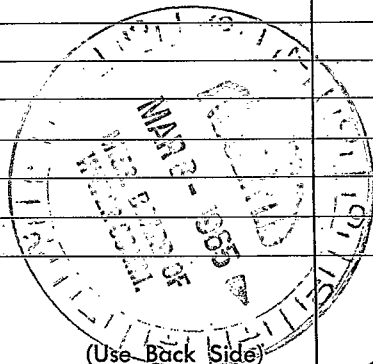

(Use Back Side)

Well

SON, Miss
No. 1