

G35

6-10-65

WATER WELL DRILLERS LOG

Date: June 10, 1965, Driller: Porter Drilling Co., Inc. Wayne  
 3P (Name)

	Description & Color of Materials Sand, Clay, Red Clay, Shell, etc.	Thick- ness Feet	Depth Feet
(1) Owner of Land: <u>Jessie Langley</u> (Name)	red clay & sand	14	14
<u>At 1 Waynesboro Miss</u> (Address)	Chalk	9	23
(2) Location: <u>NW 1/4, NE 1/4, Sec. 22 T. 9 R. 8</u>	course clay sand	7	30
<u>10</u> miles <u>NW</u> , of <u>Waynesboro</u> (distance) (direction) (Nearest Town)	sand to chalk	10	40
(3) Topography: <u>hilly</u> (Hilly) (Flat) (Level)	blue chalk	34	74
(4) Purpose of Well: <u>domestic</u> (Domestic Irrigation Municipal, Industrial, Other)	soft rock	7	81
	Chalk	4	85
	hard rock strata	18	103
	Chalk	8	111
	rock	14	125
	Chalk	2	127
	red course sand	11	138
	strata on chalk		
	& sand mixture		


Information upon completion of well:

- (1) Diameter 2" inches.
- (2) Total Depth 127 feet.
- (3) Water Level 66' feet below top of ground.
- (4) Cased to 122', Size 2"
- (5) Screen: Size 1 1/4", Length 5'  
8 slot Johnson S.S.
- (6) Were any formations sealed against pollution?  
 yes,  no.

If YES depth of formation \_\_\_\_\_

Why \_\_\_\_\_

Drillers Remarks: \_\_\_\_\_

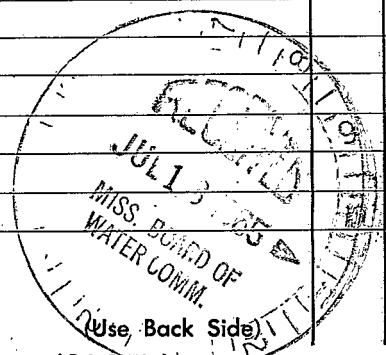

Well No. \_\_\_\_\_

