

WAYNE MISSISSIPPI BOARD OF WATER COMMISSIONERS

G 36

6-19-65

WATER WELL DRILLERS LOG


Date: June 19, 1965, Driller: Porter Drilling & Pipe Co. Wayne  
 3P (Name)

(1) Owner of Land:	Description & Color of Materials Sand, Clay, Red Clay, Shell, etc.	Thick- ness Feet	Depth Feet
<u>West Gladys Grove Baptist Church</u> <u>At 1 1/2 maysboro</u> (Address)	<u>red clay &amp; chalk</u>	<u>20</u>	<u>20</u>
(2) Location: <u>SW 1/4, SW 1/4, Sec. 35 T. 9 R. 8</u>	<u>sand</u>	<u>10</u>	<u>30</u>
<u>9</u> miles <u>west</u> , of <u>Maysboro</u> (distance) (direction) (Nearest Town)	<u>shale rock</u>	<u>30</u>	<u>30</u>
(3) Topography: <u>hilly</u>	<u>Chalk</u>	<u>73</u>	<u>103</u>
(4) Purpose of Well: <u>domestic</u>	<u>rock</u>	<u>1</u>	<u>104</u>
(Domestic Irrigation Municipal, Industrial, Other)	<u>red sand</u>	<u>11</u>	<u>115</u>
	<u>med white sand</u>	<u>8</u>	<u>153</u>
	<u>strat white</u>		
	<u>stiller sand</u>		

Information upon completion of well:

- (1) Diameter 2" inches.
- (2) Total Depth 153' feet.
- (3) Water Level 72' feet below top of ground.
- (4) Cased to 126', Size 2"
- (5) Screen: Size 1 1/4", Length 5'
- (6) Were any formations sealed against pollution?  
7 slot Johnson SS. screen  
with 20' 1 1/4" cap  
 yes, X no.

If YES depth of formation \_\_\_\_\_  
 Why \_\_\_\_\_  
 Drillers Remarks: \_\_\_\_\_

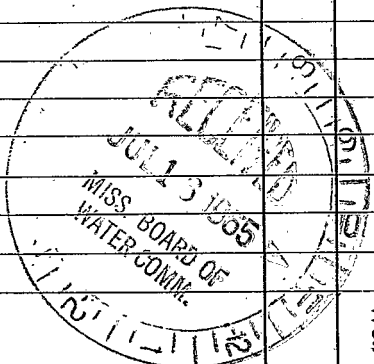

(Use Back Side)

Well No.

