

G38

8-12-65

WATER WELL DRILLERS LOG


Date: Aug 12, 1965, Driller: Porter Drilling Co County Wayne  
 3P (Name)

(1) Owner of Land:	Description & Color of Materials Sand, Clay, Red Clay, Shell, etc.	Thick- ness Feet	Depth Feet
<u>Archie Pitts</u> (Name) <u>At 1 Waynesboro, Miss</u> (Address)	<u>red clay</u>	<u>8</u>	<u>8</u>
(2) Location: <u>NE 1/4, NE 1/4, Sec. 5 T. 9 R. 8</u> <u>10 miles west</u> of <u>Waynesboro</u> (distance) (direction) (Nearest Town)	<u>chalk</u> <u>fine chalky sand</u> <u>med sand some</u> <u>chalk</u>	<u>34</u> <u>5</u> <u>20</u>	<u>42</u> <u>47</u> <u>67</u>
(3) Topography: <u>Hilly</u> (Hilly) (Flat) (Level)	<u>stopped while still</u> <u>in sand</u>		
(4) Purpose of Well: <u>domestic</u> (Domestic Irrigation Municipal, Industrial, Other)			

Information upon completion of well:

- (1) Diameter 2" inches.
- (2) Total Depth 67' feet.
- (3) Water Level 42 feet below top of ground.
- (4) Cased to 54', Size 2"
- (5) Screen: Size 1 1/4", Length 12'  
80 ga
- (6) Were any formations sealed against pollution?  
 yes,  no.

If YES depth of formation \_\_\_\_\_  
 Why \_\_\_\_\_  
 Drillers Remarks: \_\_\_\_\_

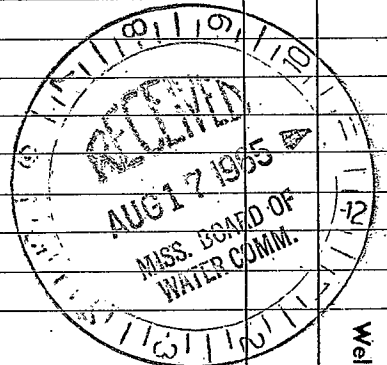

(Use Back Side)

Well No.

